


KOLB LAND CONSULTING, INC.  
LAND SURVEYING • SUBDIVIDING • LAND PLANNING

LAKE GENEVA, WISCONSIN 53147 414-248-3697


NOTE: SURVEY NOT VALID UNLESS  
SURVEYOR'S SIGNATURE IS IN  
RED.

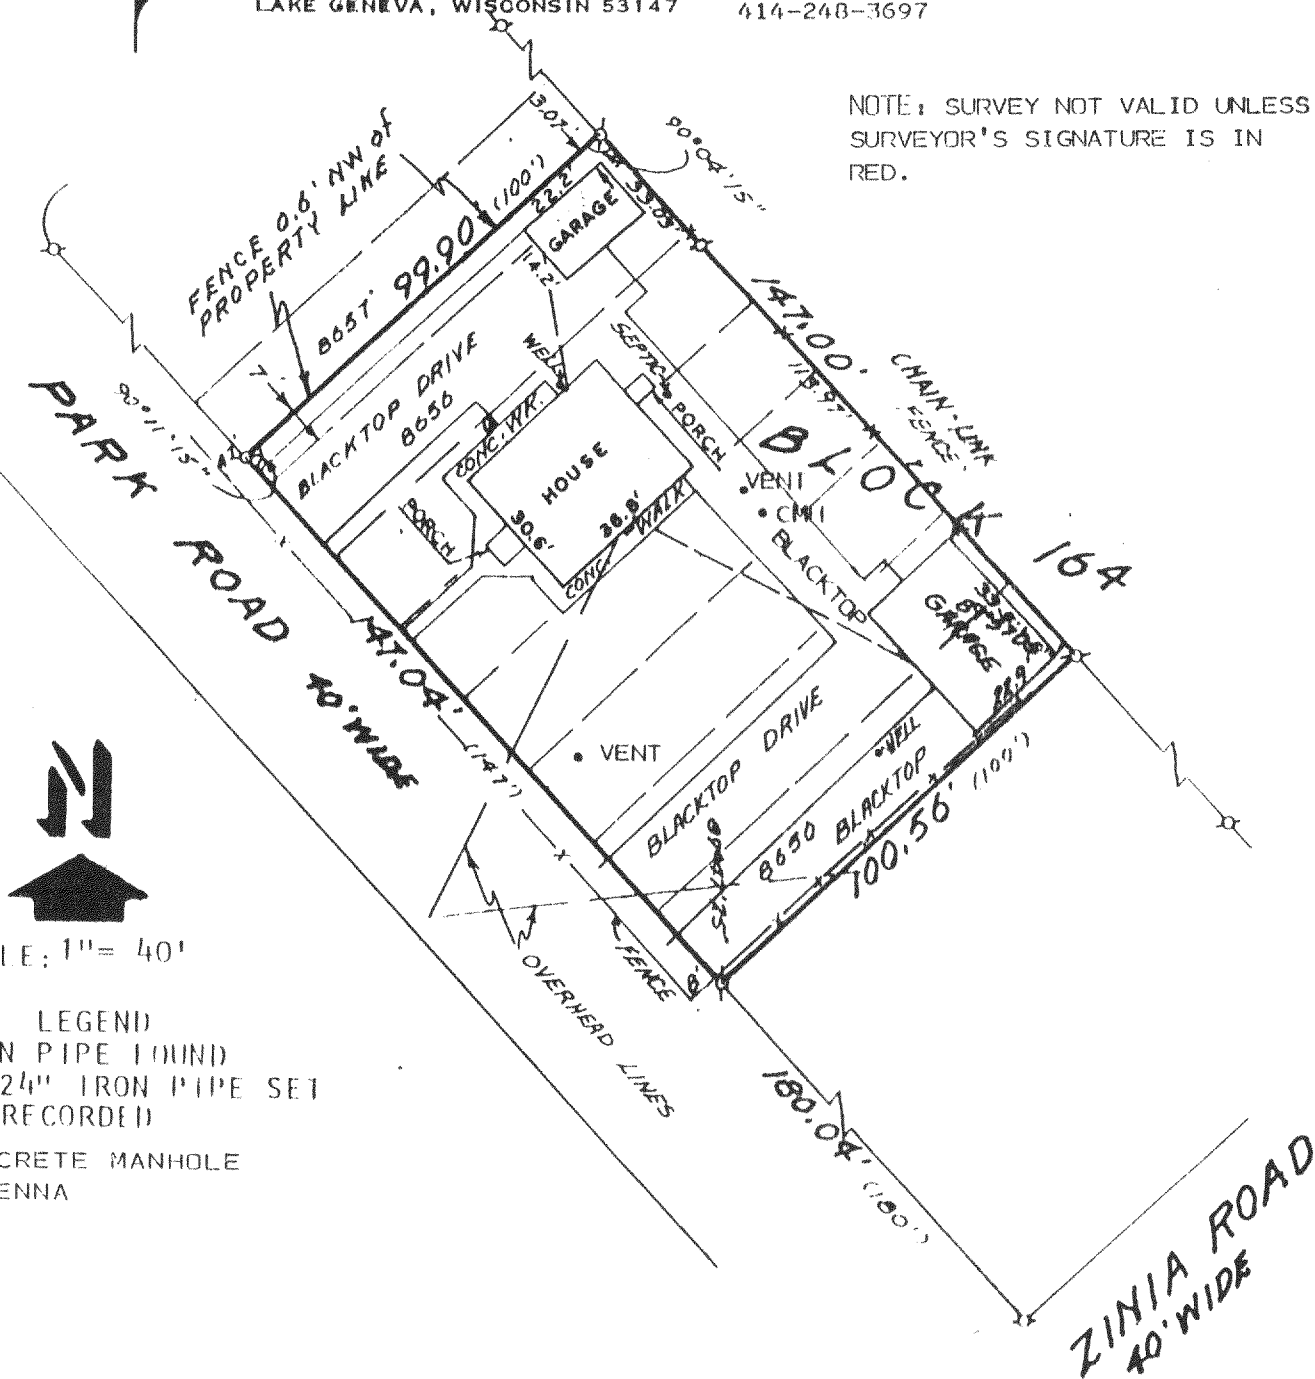

PLAT OF SURVEY OF  
 LOTS 8650-8656 AND THE SOUTHEASTERLY 7.00 FEET OF LOT 8657, BLOCK 164,  
 PILL LAKE, A SUBDIVISION LOCATED IN SECTION 22, T1N, R18E, TOWN  
 OF BLOOMFIELD, WALWORTH COUNTY, WISCONSIN.

ORDERED BY: KAZIMER YAWORSKI  
 TAGGERT-REALTY WORLD  
 612 WILLIAMS ST.  
 LAKE GENEVA, WI. 53147

I HEREBY CERTIFY THAT I HAVE SURVEYED THE  
 ABOVE DESCRIBED PROPERTY AND THAT THE ABOVE  
 MAP IS A TRUE REPRESENTATION THEREOF AND  
 SHOWS THE SIZE AND LOCATION OF THE PROPERTY,  
 ITS EXTERIOR BOUNDARIES, THE LOCATION OF ALL  
 VISIBLE STRUCTURES AND DIMENSIONS OF ALL  
 PRINCIPAL BUILDINGS THEREON, BOUNDARY FENCES,  
 APPARENT EASEMENTS, ROADWAYS AND VISIBLE  
 ENCROACHMENTS, IF ANY, TO THE BEST OF MY  
 KNOWLEDGE AND BELIEF.  
 THIS SURVEY IS MADE FOR THE USE OF THE  
 PRESENT OWNERS OF THE PROPERTY, AND ALSO  
 THOSE WHO PURCHASE, MORTGAGE, OR GUARANTEE  
 THE TITLE THERETO WITHIN ONE (1) YEAR FROM  
 THE DATE HEREOF.

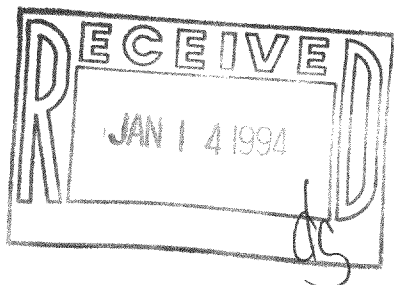

HAROLD H. KOLB  
 WISCONSIN REGISTERED LAND SURVEYOR, S-187  
 DATE AUGUST 30, 1993

MPL-1738

118-1286

118 MPL-2501