


KOLB LAND CONSULTING, INC.
 LAND SURVEYING · SUBDIVIDING · LAND PLANNING

929 WILLIAMS STREET LAKE GENEVA, WISCONSIN 53147 414-248-3697



ORDERED BY: MIKE D'ANGELO
 3418 S. WALLACE
 CHICAGO, IL. 60616

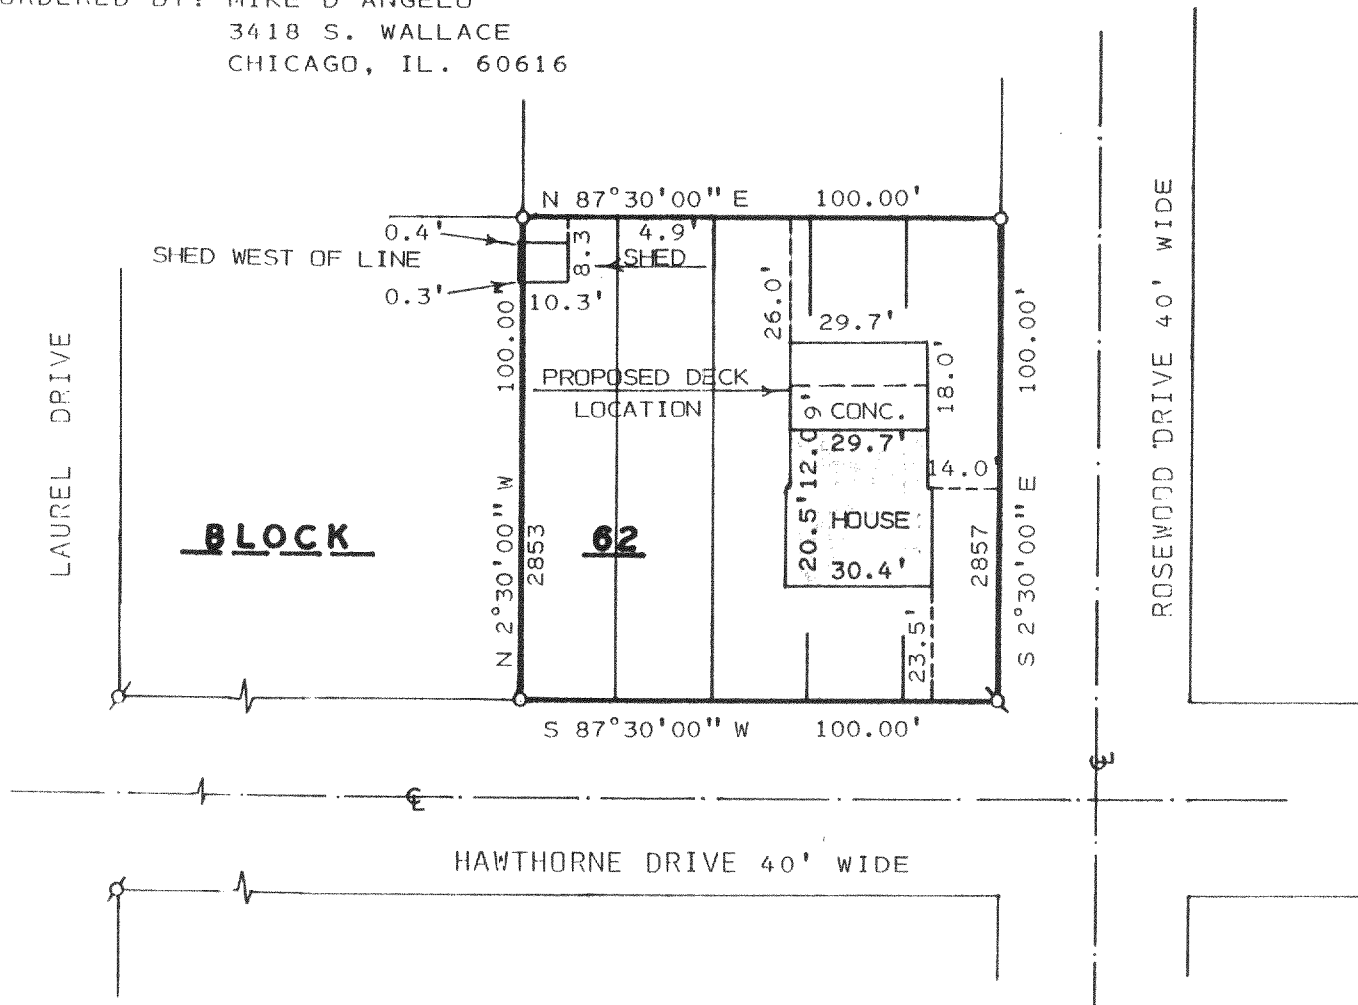

PLAT OF SURVEY OF

LOTS 2853-2857, BLOCK 62 OF PELL LAKE
 SUBDIVISION LOCATED IN T1N, R18E, TOWN
 OF BLOOMFIELD, WALWORTH COUNTY, WISCONSIN.

NOTE: BEARINGS ARE ASSUMED AS SHOWN
 ON PREVIOUS SURVEY RECORDS.

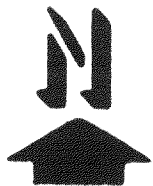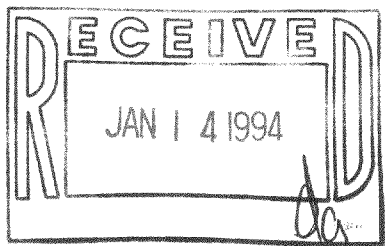

SCALE: 1" = 40'
 LEGEND

∅ - IRON PIPE FOUND
 ○ - IRON PIPE SET

I, HAROLD H. KOLB, DO HEREBY CERTIFY
 THAT I HAVE SURVEYED THE PROPERTY
 HEREON DESCRIBED ACCORDING TO THE
 OFFICIAL RECORDS AND THAT THE PLAT
 HEREON IS A CORRECT REPRESENTATION
 OF THE LOT LINES AND THE PRINCIPAL
 LINES OF THE BUILDINGS, TO THE BEST
 OF MY KNOWLEDGE AND BELIEF.
 SURVEY NOT VALID UNLESS SURVEYOR'S SIGNATURE
 IS IN RED.

HAROLD H. KOLB

WISCONSIN REGISTERED LAND SURVEYOR, S-187

DATE _____


REVISED _____

REVISED _____

KOLB LAND CONSULTING, INC.
 LAND SURVEYING · SUBDIVIDING · LAND PLANNING


929 WILLIAMS STREET LAKE GENEVA, WISCONSIN 53147 414-248-3697

ORDERED BY: MIKE D'ANGELO
 3418 S. WALLACE
 CHICAGO, IL. 60616

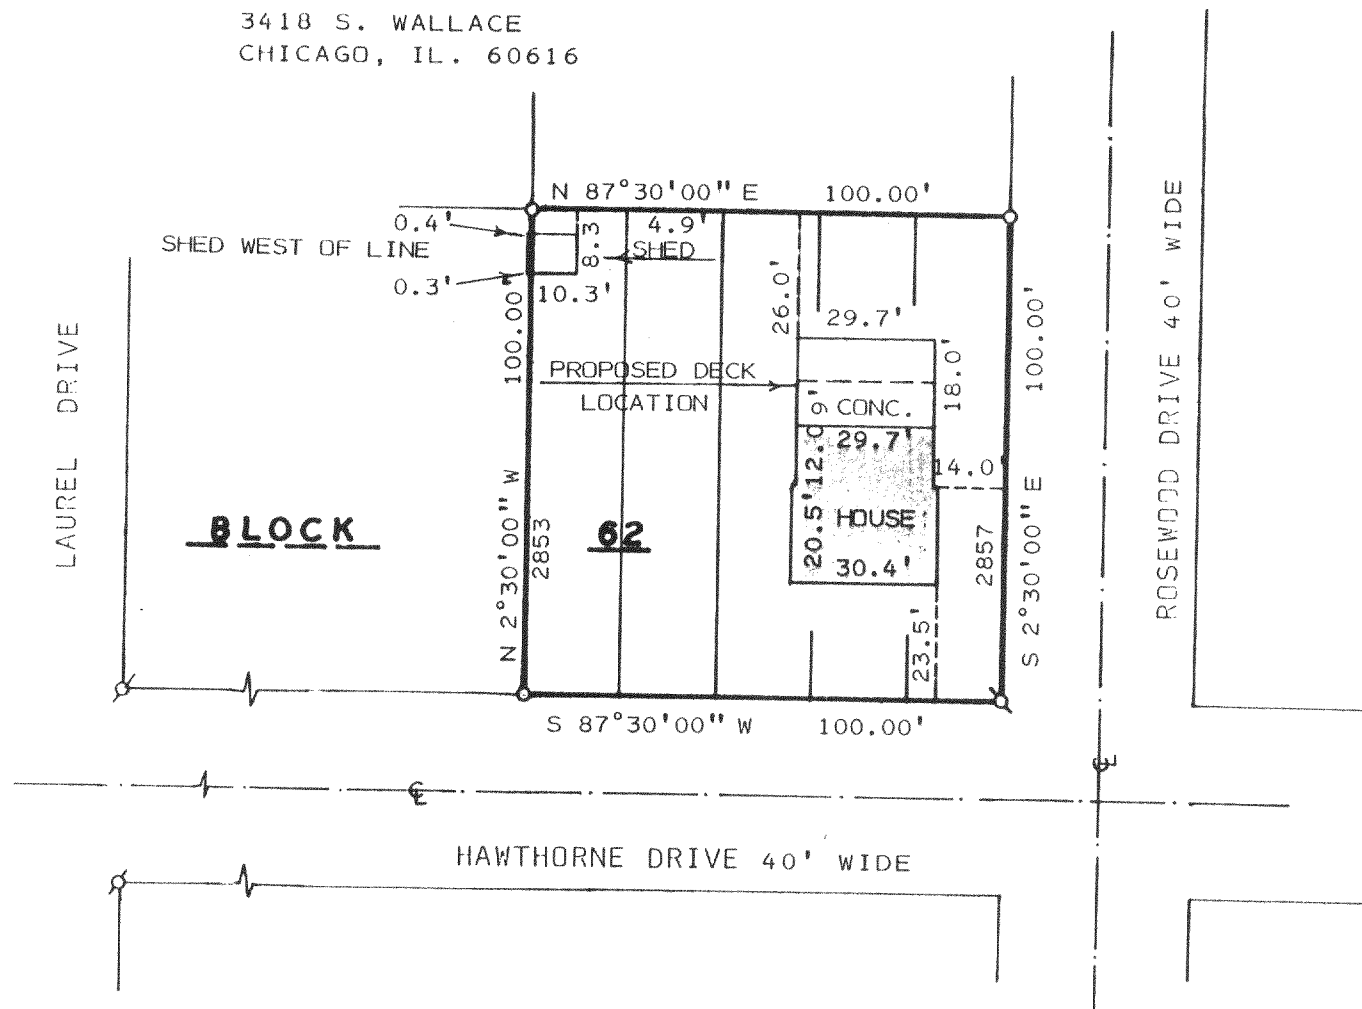


PLAT OF SURVEY OF

LOTS 2853-2857, BLOCK 62 OF PELL LAKE
 SUBDIVISION LOCATED IN T1N, R18E, TOWN
 OF BLOOMFIELD, WALWORTH COUNTY, WISCONSIN.

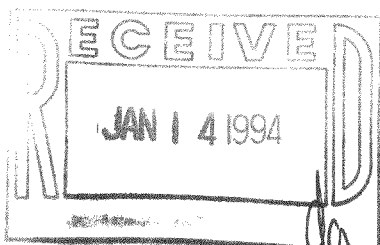

NOTE: BEARINGS ARE ASSUMED AS SHOWN
 ON PREVIOUS SURVEY RECORDS.

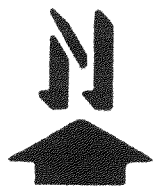

SCALE: 1" = 40'

LEGEND

- ⊕ - IRON PIPE FOUND
- - IRON PIPE SET

I, HAROLD H. KOLB, DO HEREBY CERTIFY
 THAT I HAVE SURVEYED THE PROPERTY
 HEREON DESCRIBED ACCORDING TO THE
 OFFICIAL RECORDS AND THAT THE PLAT
 HEREON IS A CORRECT REPRESENTATION
 OF THE LOT LINES AND THE PRINCIPAL
 LINES OF THE BUILDINGS, TO THE BEST
 OF MY KNOWLEDGE AND BELIEF.
 SURVEY NOT VALID UNLESS SURVEYOR'S SIGNATURE
 IS IN RED.

HAROLD H. KOLB

WISCONSIN REGISTERED LAND SURVEYOR, S-187

DATE JUNE 21, 1993

REVISED _____

REVISED _____