
ABELL SURVEYING & MAPPING DELAVAN. WISCONSIN 53115 414-728-6737

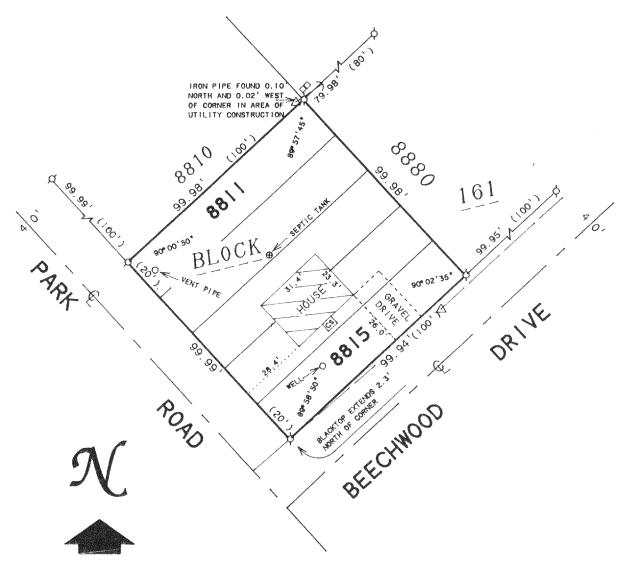

SCALE | " =40' LEGEND

\$ - IRON PIPE FOUND

CS -CONCRETE STOOP

A -UTILITY POLE

-GUY WIRE

DD -UTILITY PED.

-OVERHEAD UTILITY LINE

()-RECORDED AS

PLAT OF SURVEY OF

LOTS 8811 - 8815, BLOCK 161 OF PELL LAKE SUBDIVISION, LOCATED IN TIN, R18E, WALWORTH COUNTY, WISCONSIN.



I HEREBY CERTIFY THAT I HAVE SURVEYED THE ABOVE DESCRIBED PROPERTY AND THAT THE ABOVE MAP IS A TRUE REPRESENTATION THEREOF AND SHOWS THE SIZE AND LOCATION OF THE PROPERTY. ITS EXTERIOR BOUNDARIES, THE LOCATION OF ALL VISIBLE STRUCTURES AND DIMENSIONS OF ALL PRINCIPAL BUILDINGS THEREON. BOUNDARY FENCES. APPARENT EASEMENTS, ROADWAYS AND VISIBLE ENCROACHMENTS, IF ANY, TO THE BEST OF MY KNOWLEDGE AND BELIEF.

SURVEY IS MADE FOR THE USE OF THE PRESENT OWNERS OF THE PROPERTY, AND ALSO WHO PURCHASE, MORTGAGE, OR GUARANTEE THE TITLE THERETO WITHIN ONE (I) YEAR DATE HEREON.

DAVID F. ABELL WISCONSIN REGISTERED LAND SURVEYOR, S-1596

ORDERED BY: WILLIAM HELLYER
10 WEST TERRA COTTA

CRYSTAL LAKE. IL 60014

November 2, 1992

REVISED DATE AUGUST 31, 1993

DATE JOB NUMBER - 91143 NOTE: THIS IS NOT A CERTIFIED COPY UNLESS SEALED.