LOTS 9672 THRU 9680 IN BLOCK 212, OF SECTION 7 OF PELL LAKE SUBIDIVISION, LOCATED IN THE NORTHEAST 1/4 OF SECTION 21, T. 1 N., R. 18 E. OF THE 4TH P.M., TOWNSHIP OF BLOOMFIELD, COUNTY OF WALWORTH, STATE OF WIS CONSIN.

FOR: KRUMPEN

SCALE 1" = 40'

o = IRON PIPE SET.


ø = IRON PIPE FOUND.

I have surveyed the above-described property. and the map hereon is a true representation thereof and shows the size and location of the property, its exterior boundaries, the location and dimensions of all visible structures thereon, fences, apparent expenses and roadways and visible encreachments, if new

This survey is made for the exclusive use of the present owners of the preparty, and also those who purchase, exertence, or guarantee the title therete, within one year from date hereof,

Dated at Burtington, this ST

/John F. Dogen, Land Surveyor S 242 589 N. Pine St. Burlington, WI 53105

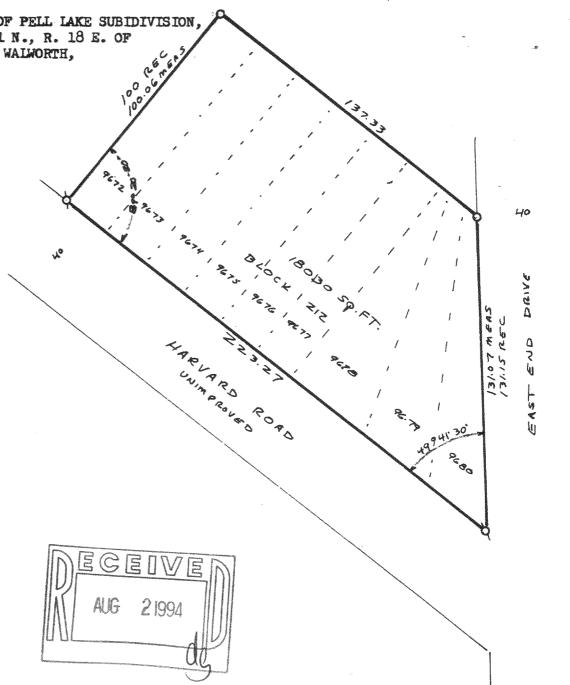

118-1355