LOTS 9697 THRU 9701 IN BLOCK 215 OF SECTION 7 OF PELL LAKE, A SUBDIVISION IN THE NORTHEAST 1/4 OF SECTION 21, T. 1 N., R. 18 E. OF THE 4TH P.M., TOWNSHIP OF BLOOMFIELD, COUNTY OF WALWORTH, STATE OF WISCONSIN.

FOR: KRUMPEN

SCALE 1" = 40'

ø = IRON PIPE FOUND


o = IRON PIPE SET.

I have surveyed the above-described property, and the map hereon is a true representation thereof and shows the size and location of the property, its exterior boundaries, the location and dimensions of all visible structures thereon, fences, apparent easements and roadways and visible encroachments, if any.

This survey is made for the exclusive use of the present owners of the property, and also those who purchase, mortgage, or guarantee the title thereto, within one year from date hereof.

Dated at Burlington, this 15T, day,

John F. Dogen, Land Surveyor \$ 242 589 N. Pine St. Burlington, WI 53105 AUG 21994

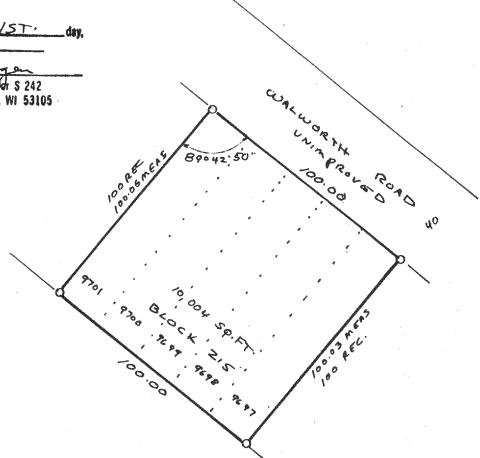

MPL-1963

R-1357 (4) 16-F-3 # 32