

WALWORTH COUNTY SURVEYING & MAPPING 727 HENRY STREET LAKE GENEVA, WISCONSIN 414-248-0505

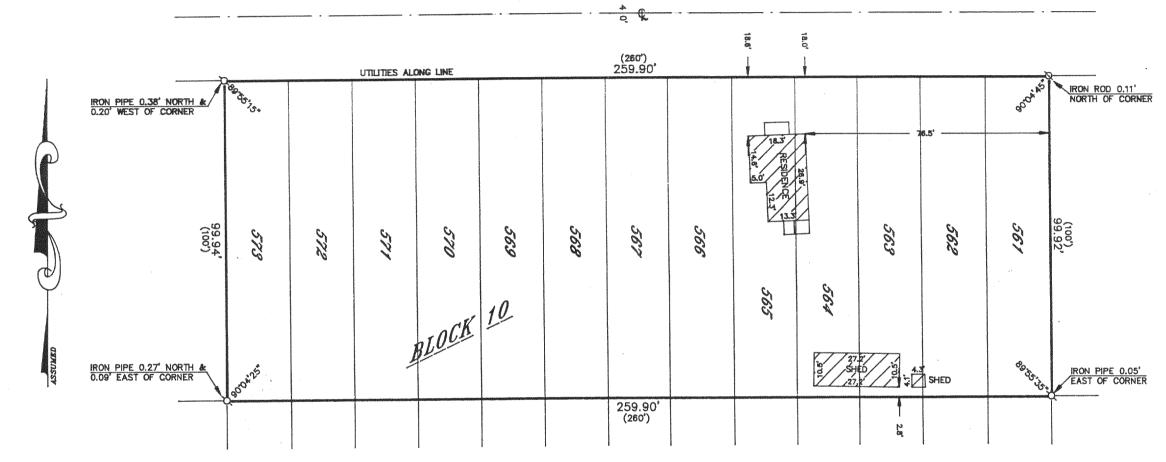

GREEN ROAD



GRAPHIC SCALE

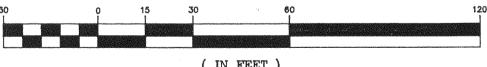

(IN FEET) 1 inch = 30 ft.

Ø-IRON PIPE FOUND Ø-IRON ROD FOUND

∅-CONCRETE MONUMENT FOUND

O-IRON PIPE PLACED ()-RECORDED AS

PLAT OF SURVEY OF

LOTS 561-573, BLOCK 10 OF PELL LAKE ADDITION, A SUBDIVISION LOCATED IN T 1 N, R 18 E, WALWORTH COUNTY, WISCONSIN.

ORDERED BY: RALPH TELLEFSON 182 OLIVE STREET ELMHURST, ILLINOIS 60126

I HEREBY CERTIFY THAT I HAVE SURVEYED THE ABOVE DESCRIBED PROPERTY AND THAT THE ABOVE MAP IS A TRUE REPRESENTATION THEREOF AND SHOWS THE SIZE AND LOCATION OF THE PROPERTY, THEREOF AND SHOWS THE SIZE AND LOCATION OF THE PROPERTY,
ITS EXTERIOR BOUNDARIES, THE LOCATION OF ALL VISIBLE STRUCTURES
AND DIMENSIONS OF ALL PRINCIPAL BUILDINGS THEREON, BOUNDARY
FENCES, APPARENT EASEMENTS, ROADWAYS AND VISIBLE ENCROACH—
MENTS, IF ANY, TO THE BEST OF MY KNOWLEDGE AND BELIEF.

THIS SURVEY IS MADE FOR THE USE OF THE PRESENT OWNERS OF THE PROPERTY AND ALSO THOSE WHO PURCHASE, MORTGAGE OR QUARANTEE THE TITLE THERETO WITHIN ONE (1) YEAR FROM DATE

RÓBERT M. BAERENWALD
WISCONSIN REGISTERED LAND SURVEYOR, S-1508

NOTE: THIS IS NOT A CERTIFIED COPY UNLESS SEALED.