

KOLB LAND CONSULTING, INC.
LAND SURVEYING • SUBDIVIDING • LAND PLANNING

929 WILLIAMS STREET

LAKE GENEVA, WISCONSIN 53147

414 240-3697





SCALE: 1" = 60'

- Ø IRON PIPE FOUND
- (2') RECORDED DISTANCE & BEARING
- IRON PIPE FOUND
- SW SIDEWALK
- TP TELEPHONE PEDISTAL

ORDERED BY: JOHN ARNOW
35033 INDIAN TRAIL ROAD
INGLESIDE IL 60041

NOTE: BEARINGS ARE ASSUMED AS
SHOWN ON THE RECORDED PLAT
OF PELL LAKE.

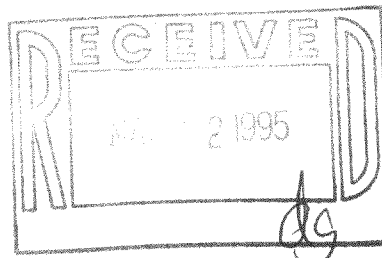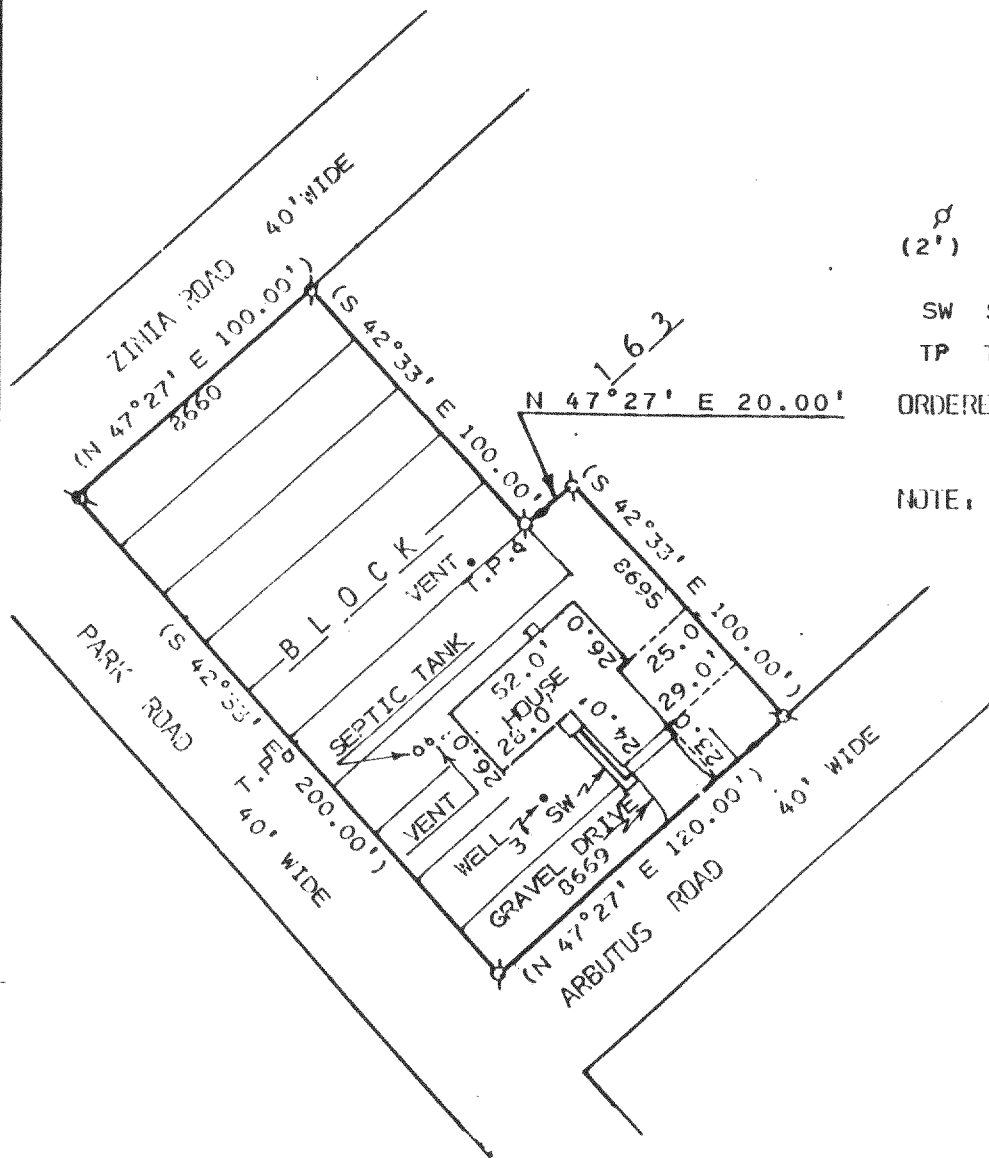


PLAT OF SURVEY OF

LOTS 8660-8669 AND 8695, BLOCK 163, PELL LAKE, A SUBDIVISION
LOCATED IN SECTION 22, T 1 N, R 18 E, TOWN OF BLOOMFIELD,
WALWORTH COUNTY, WISCONSIN.

I, HAROLD H. KOLB, CERTIFY THAT I HAVE SURVEYED THE ABOVE
DESCRIBED PROPERTY AND THAT THE ABOVE PLAT IS A TRUE
REPRESENTATION THEREOF AND SHOWS THE SIZE AND LOCATION
OF THE PROPERTY, IT'S EXTERIOR BOUNDARIES, THE LOCATION
OF ALL VISIBLE STRUCTURES AND DIMENSIONS OF ALL PRINCIPAL
BUILDINGS THEREON, BOUNDARY FENCES, APPARENT EASEMENTS,
ROADWAYS AND VISIBLE ENCROACHMENT ANY TO THE BEST
OF MY KNOWLEDGE AND BELIEF.

THIS SURVEY IS MADE FOR THE USE OF THE PRESENT OWNERS OF
THE PROPERTY, AND ALSO THOSE WHO PURCHASE, MORTGAGE,
OR GUARANTEE TITLE THERETO WITHIN ONE (1) YEAR FROM THE
DATE HEREOF.

NOTE: THIS SURVEY IS NOT VALID UNLESS SURVEYOR'S SIGNATURE
IS IN RED.

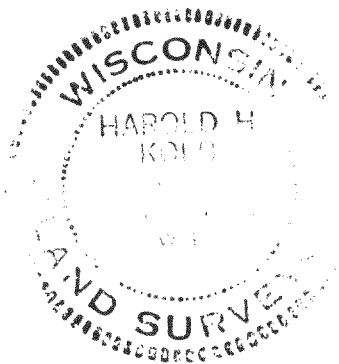

HAROLD H. KOLB
WISCONSIN REGISTERED LAND SURVEYOR, S-187
DATE NOVEMBER 29, 1994
REVISED _____
REVISED _____

MPL-1740 (1741)

118-1440

1-18/11PL2505

KOLB LAND CONSULTING, INC.
LAND SURVEYING • SUBDIVIDING • LAND PLANNING

929 WILLIAMS STREET LAKE GENEVA, WISCONSIN 53147 414-240-3697




SCALE: 1" = 60'

- Ø IRON PIPE FOUND
- (2') RECORDED DISTANCE & BEARING
- IRON PIPE FOUND
- SW SIDEWALK
- TP TELEPHONE PEDISTAL


ORDERED BY: JOHN ARNOW
35033 INDIAN TRAIL ROAD
INGLESIDE IL 60041

NOTE: BEARINGS ARE ASSUMED AS
SHOWN ON THE RECORDED PLAT
OF PELL LAKE.

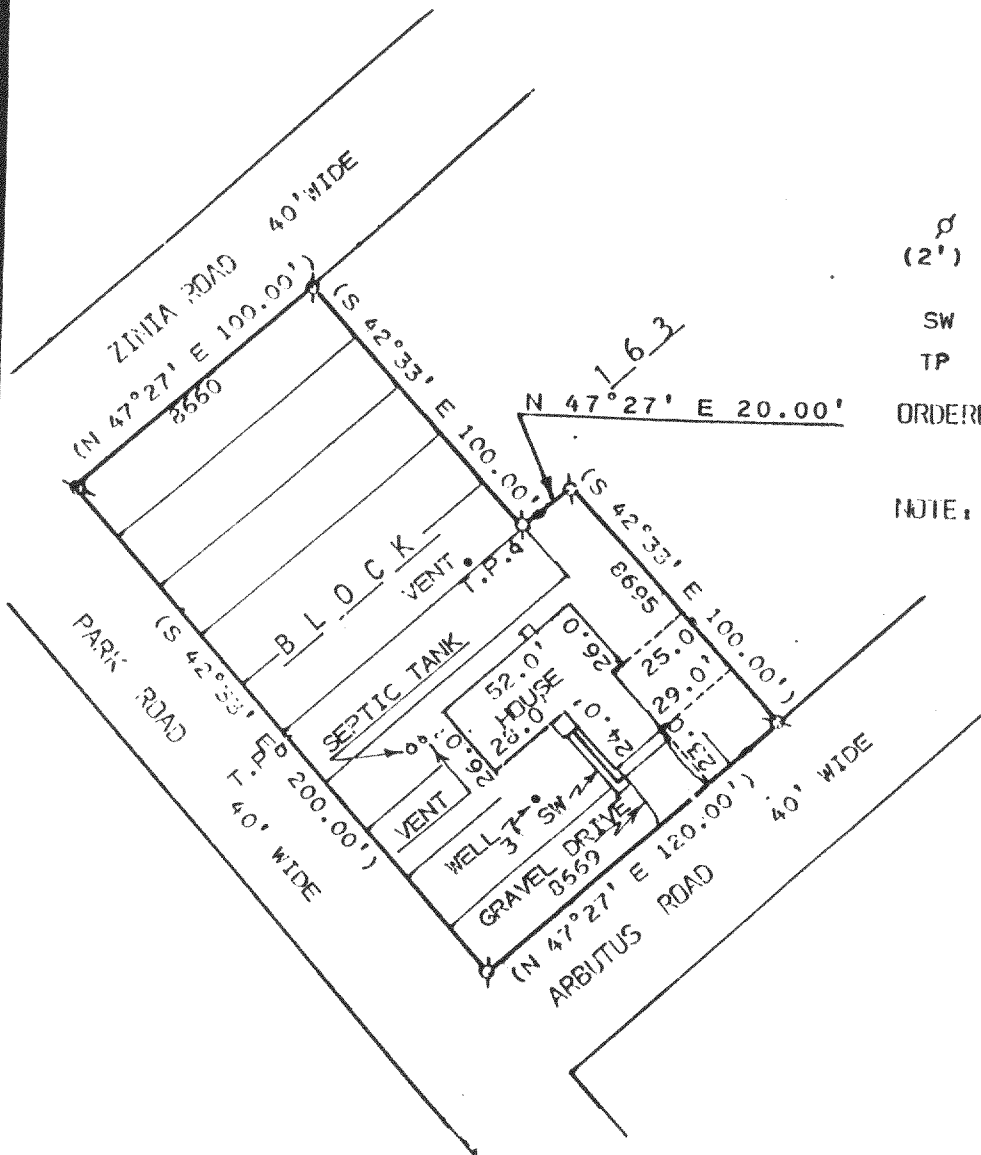

PLAT OF SURVEY OF

LOTS 8660-8669 AND 8695, BLOCK 163, PELL LAKE, A SUBDIVISION
LOCATED IN SECTION 22, T 1 N, R 18 E, TOWN OF BLOOMFIELD,
WALWORTH COUNTY, WISCONSIN.

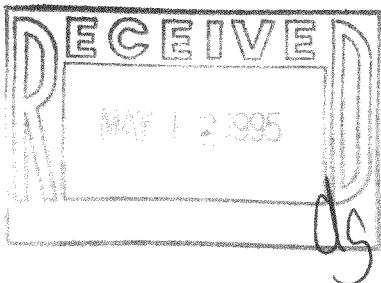

I, HAROLD H. KOLB, CERTIFY THAT I HAVE SURVEYED THE ABOVE
DESCRIBED PROPERTY AND THAT THE ABOVE PLAT IS A TRUE
REPRESENTATION THEREOF AND SHOWS THE SIZE AND LOCATION
OF THE PROPERTY, IT'S EXTERIOR BOUNDARIES, THE LOCATION
OF ALL VISIBLE STRUCTURES AND DIMENSIONS OF ALL PRINCIPAL
BUILDINGS THEREON, BOUNDARY FENCES, APPARENT EASEMENTS,
ROADWAYS AND VISIBLE ENCROACHMENT ANY TO THE BEST
OF MY KNOWLEDGE AND BELIEF.

THIS SURVEY IS MADE FOR THE USE OF THE PRESENT OWNERS OF
THE PROPERTY, AND ALSO THOSE WHO PURCHASE, MORTGAGE,
OR GUARANTEE TITLE THERETO WITHIN ONE (1) YEAR FROM THE
DATE HEREOF.

NOTE: THIS SURVEY IS NOT VALID UNLESS SURVEYOR'S SIGNATURE
IS IN RED.

HAROLD H. KOLB
WISCONSIN REGISTERED LAND SURVEYOR, S-187
DATE NOVEMBER 23, 1994.

REVISED _____
REVISED _____