


KOLB LAND CONSULTING, INC.
 LAND SURVEYING · SUBDIVIDING · LAND PLANNING

929 WILLIAMS STREET LAKE GENEVA, WISCONSIN 53147 414-240-3697

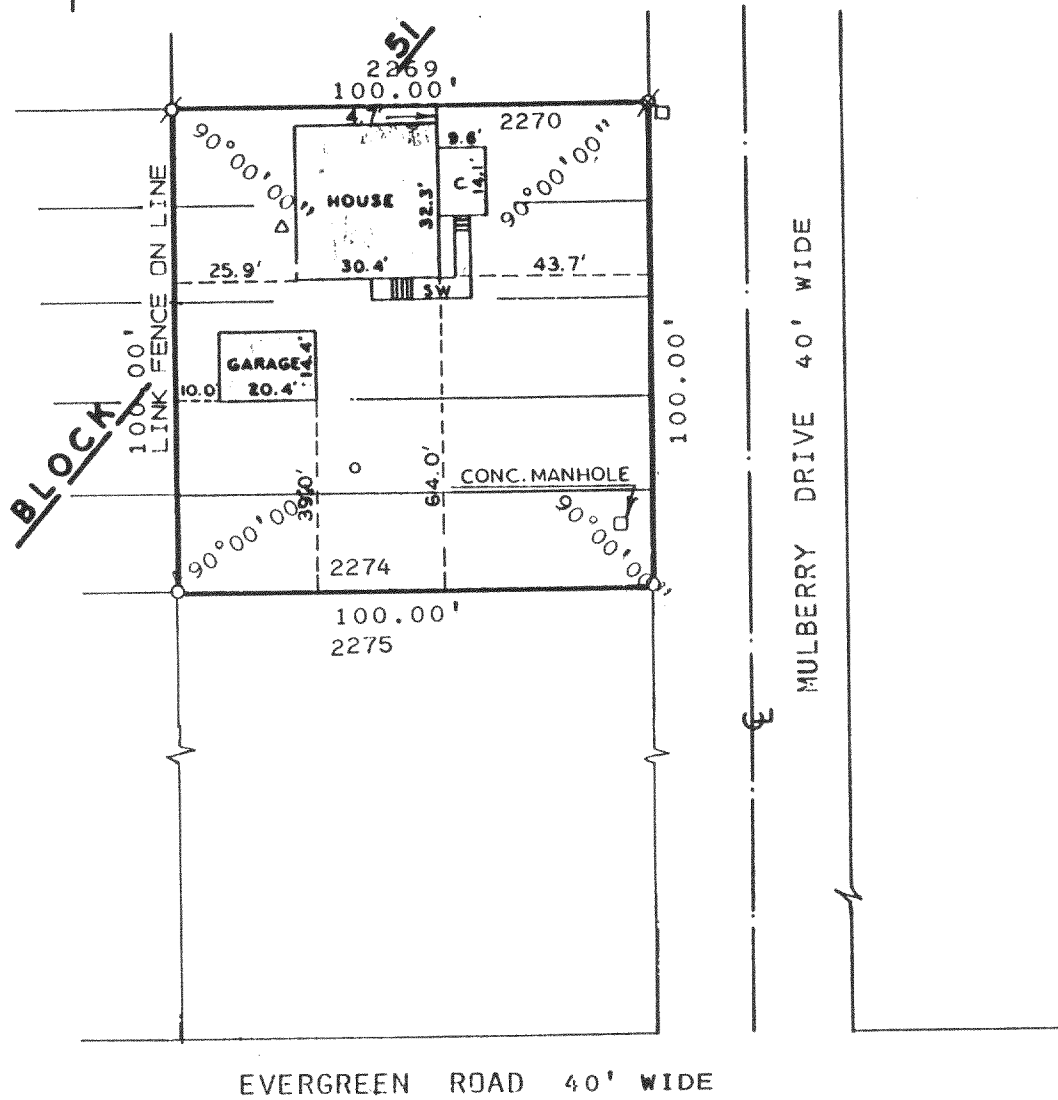

ORDERED BY: LOUANNE ERICSON
 P.O. BOX 83
 PELL LAKE, WI. 53157

PLAT OF SURVEY OF

LOTS 2270-2274, BLOCK 51 OF PELL LAKE
 SUBDIVISION LOCATED IN T1N, R18E, TOWN
 OF BLOOMFIELD, WALWORTH COUNTY, WISCONSIN.




SCALE: 1" = 40'
 LEGEND

- ⊘ - IRON PIPE FOUND
- - IRON PIPE SET
- △ - T.V. ANTENNA
- - UTILITY PEDISTAL
- SW - SIDEWALK
- C. - CONCRETE
- ⊗ - SPIKE FOUND

I, HAROLD H. KOLB, CERTIFY THAT I HAVE SURVEYED THE ABOVE DESCRIBED PROPERTY AND THAT THE ABOVE PLAT IS A TRUE REPRESENTATION THEREOF AND SHOWS THE SIZE AND LOCATION OF THE PROPERTY, IT'S EXTERIOR BOUNDARIES, THE LOCATION OF ALL VISIBLE STRUCTURES AND DIMENSIONS OF ALL PRINCIPAL BUILDINGS THEREON, BOUNDARY FENCES, APPARENT EASEMENTS, ROADWAYS AND VISIBLE ENCROACHMENTS, IF ANY TO THE BEST OF MY KNOWLEDGE AND BELIEF.

THIS SURVEY IS MADE FOR THE USE OF THE PRESENT OWNERS OF THE PROPERTY, AND ALSO THOSE WHO PURCHASE, MORTGAGE, OR GUARANTEE TITLE THERETO WITHIN ONE (1) YEAR FROM THE DATE HEREOF.

NOTE: THIS SURVEY IS NOT VALID UNLESS SURVEYOR'S SIGNATURE IS IN RED.

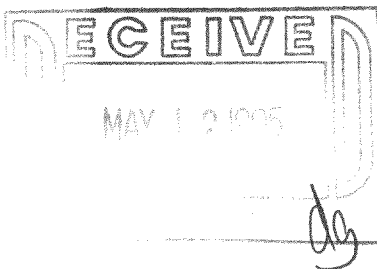

HAROLD H. KOLB

WISCONSIN REGISTERED LAND SURVEYOR, S- 187

DATE OCTOBER 31, 1994

REVISED _____

REVISED _____

1-18-434

MPL-472

118-1460