LOTS 481 THROUGH 486 IN BLOCK 8 OF PELL LAKE ADDITION, LOCATED IN THE SOUTHWEST 1/4 OF SECTION 14, T. 1 N. R. 18 E. OF THE 4TH P.M., TOWNSHIP OF BLOOMFIELD, COUNTY OF WALWORTH, STATE OF WISCONSIN.

FOR: WEINPERT

SCALE 1'' = 30'

ø = IRON PIPE FOUND.

o = IRON PIPE SET.


+ = CHISELED CROSS IN CONCRETE.

I have surveyed the above-described property, and the map hereon is a true representation thereof and shows the size and location of the property. Its exterior boundaries, the location and dimensions of all visible structures thereon, fences, apparent easements and roadways and visible encroachments, if any.

This survey is made for the exclusive use of the present owners of the property, and also those who purchase, mortgage, or guarantee the title thereto, within one year from date hereof.

Dated at Burlington, this ZS+H day,

John F. Degen, Land Surveyor S 242 589 N. Pine St. Burlington, WI 53105

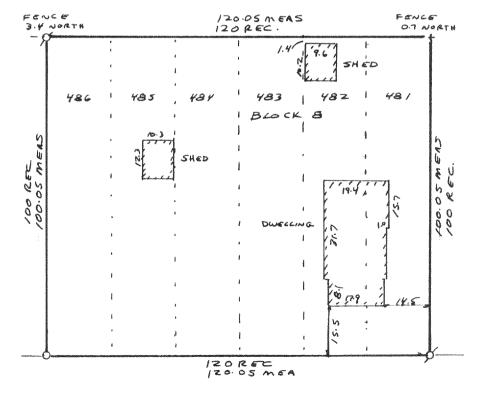

DEGETVE JUL 2 11 1995

& GREEN ST.