LOT 11, BLOCK 6, ROSE NIPPERSINK CARDENS SUBDIVISION, EXCEPT THE SOUTH 15 FEET THEREOF, LOCATED IN SEL/4 SECTION 24, T. 1 N., R. 18 E., OF THE 4TH P. M., TOWNSHIP OF BLOOMFIELD, COUNTY OF WALMORTH, STATE OF WISCONSIN.

POR: PALAZZO

8CALE: 1" - 40'


O . IRON PIPE STAKE FOUND.

o = IRON PIPE STAKE SET.

BEARINGS ARE THOSE OF RECORDED PLAT.

I have surveyed the above described property. and the map hereon is a true representation thereof and shows the size and location of the property. Its exterior boundaries, the location and dimensions of all visible structures thereon. fences, apparent easements and roadways and visible encroachments, if any.

This survey is made for the exclusive use of the present owners of the property, and elso those who purchase, mortgage, or guarantee the title thereto, within one year from date

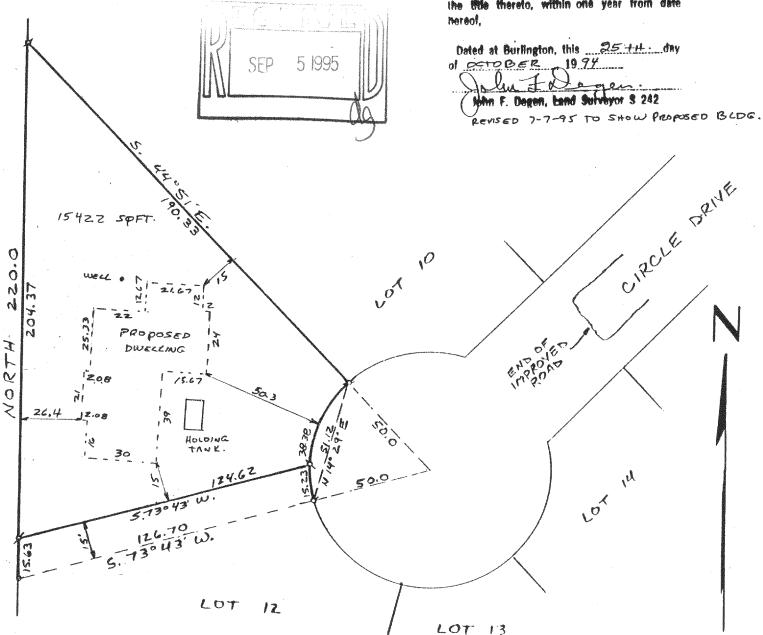

16-B #46

I

1

0