

PLAT OF SURVEY
OF



LOTS 2275 TO 2280, BOTH INCLUSIVE, AS DESIGNATED AND DELINEATED ON THE MAP ENTITLED
" MAP OF SECTION TWO OF PELL LAKE", WALWORTH COUNTY, WISCONSIN AND RECORDED IN THE OFFICE
OF THE REGISTER OF DEEDS IN AND FOR COUNTY OF WALWORTH AND STATE OF WISCONSIN ON THE
16TH DAY OF JULY 1924.

FOR: ANCHOR BANK AND LOUANNE J. ERICSON

SCALE 1" = 30'

⌵ = IRON PIPE FOUND.

○ = IRON PIPE SET.

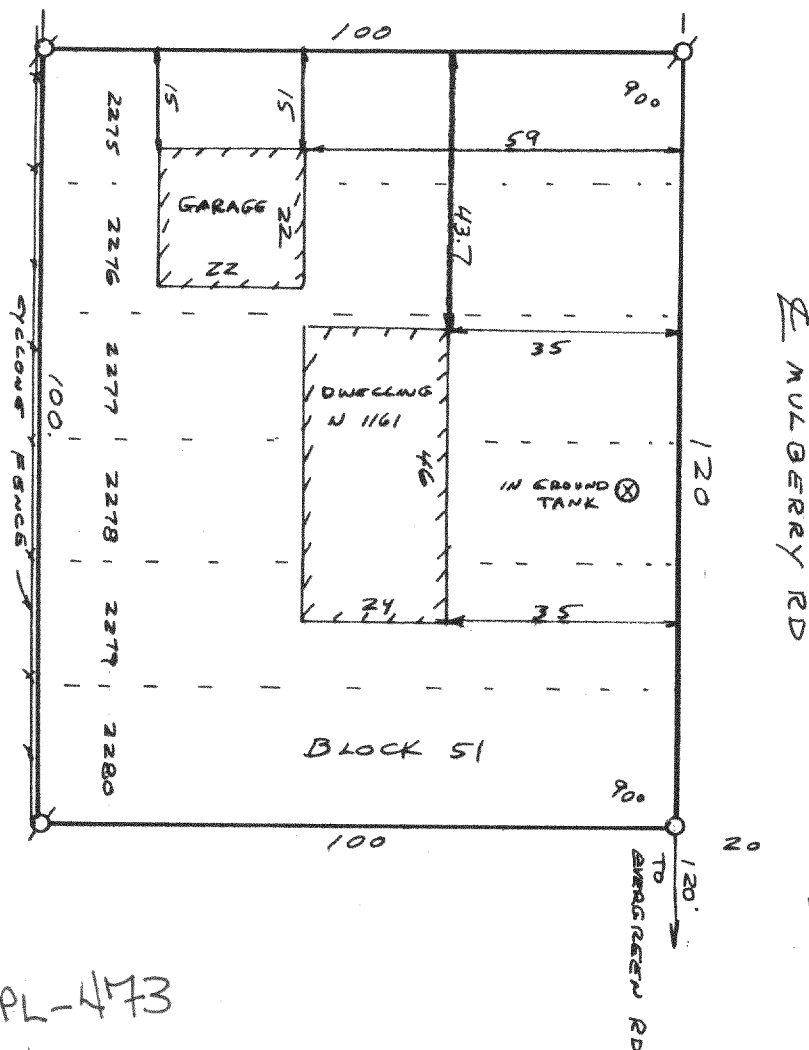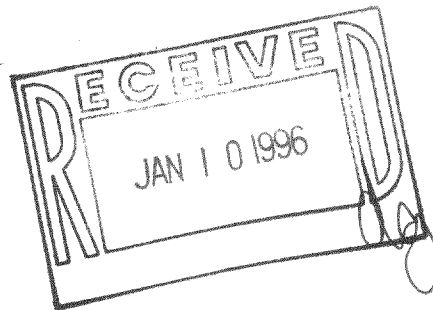

I have surveyed the above-described property, and the map hereon is a true representation thereof and shows the size and location of the property, its exterior boundaries, the location and dimensions of all visible structures thereon, fences, apparent easements and roadways and visible encroachments, if any.

This survey is made for the exclusive use of the present owners of the property, and also those who purchase, mortgage, or guarantee the title thereto, within one year from date hereof.

Dated at Burlington, this 21ST day, of NOVEMBER 1995

John F. Degen
John F. Degen, Land Surveyor S 242
489 N. Pine St. Burlington, WI 53105