

DUNHAM SURVEYING, S.C.
SURVEYING & SUBDIVIDING
DELAVER, WISCONSIN 53115

N

Scale - 1" = 20'


⊙ = 1" Iron Pipe Found
⊘ = 3/4" Iron Pipe Found
○ = 3/4" Iron Pipe Set

Bearings referenced to the northwesterly line of
West Post Road with the recorded bearing of
S37°59'00"W

Survey ordered by: Hallmark Realty
P.O. Box 730
Pell Lake, WI 53157

Updating to show proposed building location
ordered by: Dennis Unbehaun
1945 N. Daisy
Genoa City, WI 53128

Building location ordered by:
Dennis Unbehaun
1945 N. Daisy
Genoa City, WI 53128

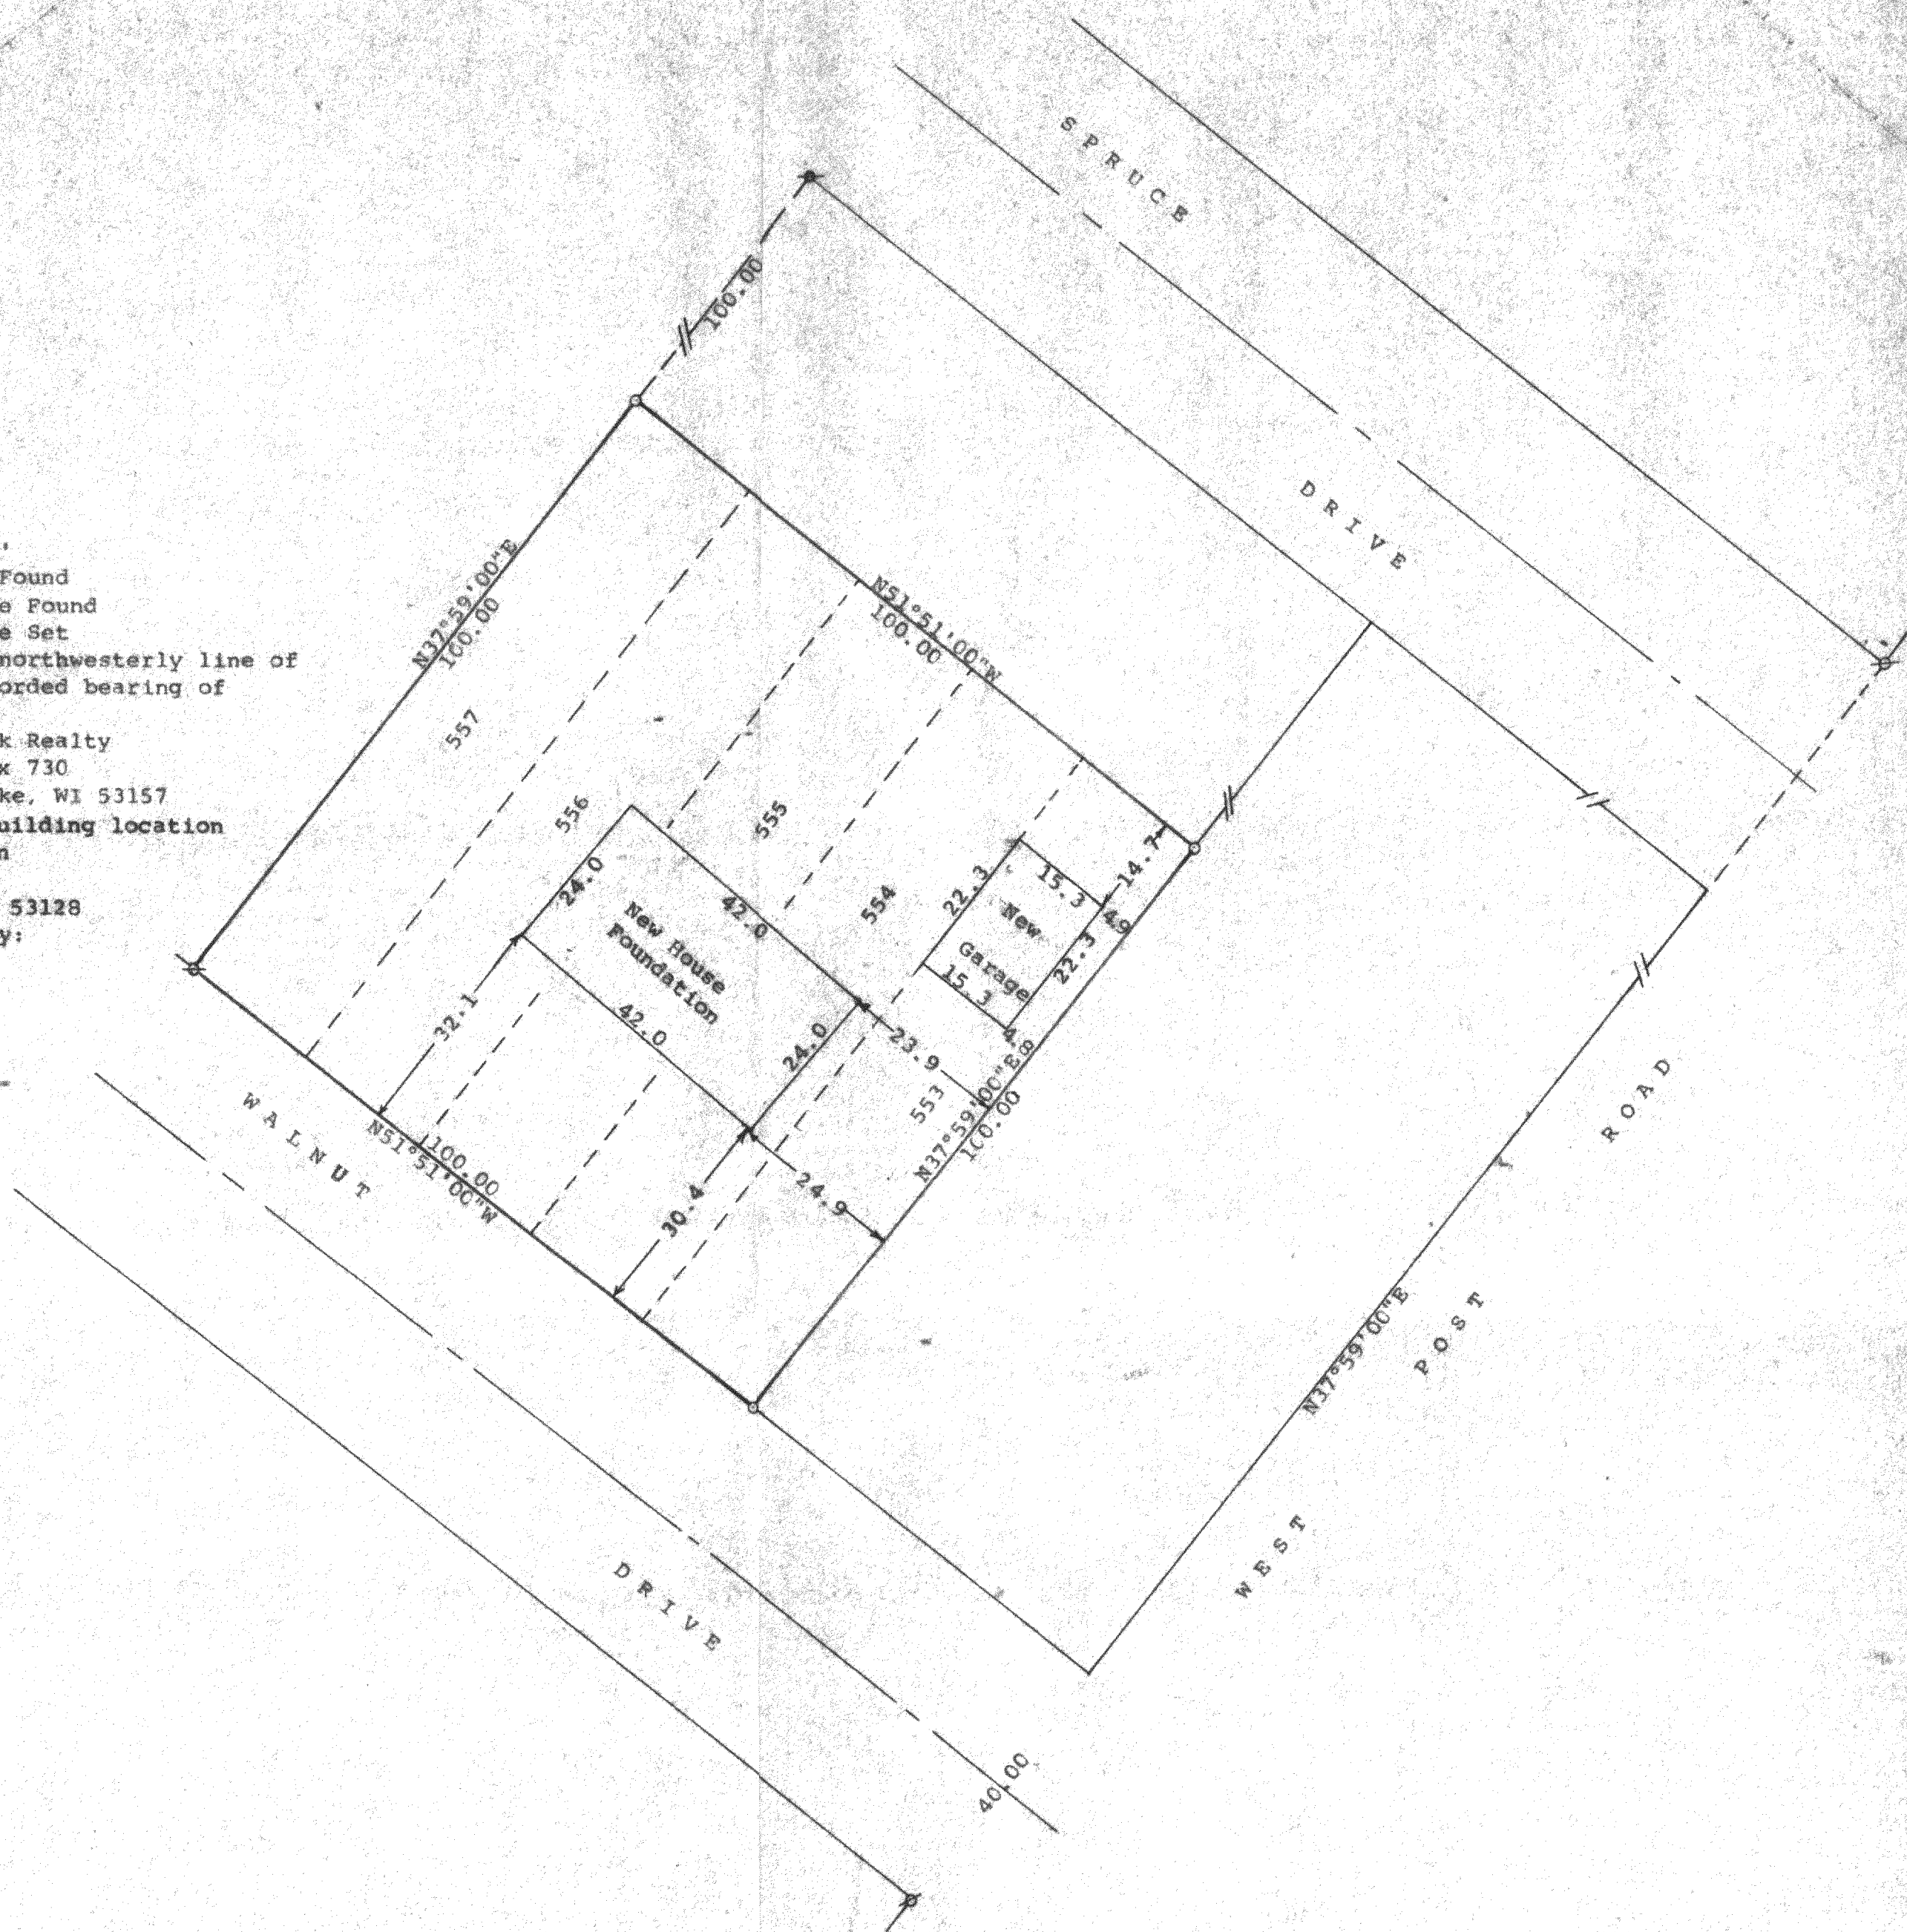

STATE OF WISCONSIN)
COUNTY OF WALWORTH) SS

I, George T. Dunham, Surveyor, certify that I have surveyed the
property described as follows:

Lots 553 to 557 inclusive in Block 11, Section 1 of Pell Lake
Subdivision located in the Town of Bloomfield, Walworth County,
Wisconsin

and that the plat shown hereon is a correct representation thereof and shows
the size and location of the property, its exterior boundaries, the location
of all visible structures and dimensions of all principal buildings thereon,
boundary fences, apparent easements, roadways and visible encroachments, if
any, and that I have surveyed the property hereon described, according to the
official records, to the best of my knowledge and belief.

February 8, 1995

Updated February 13, 1995 to
show proposed building location
Updated and recertified to this
3rd day of March, 1995 to show
house foundation
Updated and recertified to this
29th day of March, 1995 to show
new garage location

George T. Dunham
George T. Dunham, Surveyor

