
PHONE 414-537-4874 FAX 414-537-4221

Lots 1546 thru 1550, Block 34 of MAP OF SECTION 1 OF PELL LAKE, a subdivision located in Section 15, Township 1 North, Range 18 East of the 4th Principal Meridian, Township of Bloomfield, County of Walworth, State of Wisconsin.

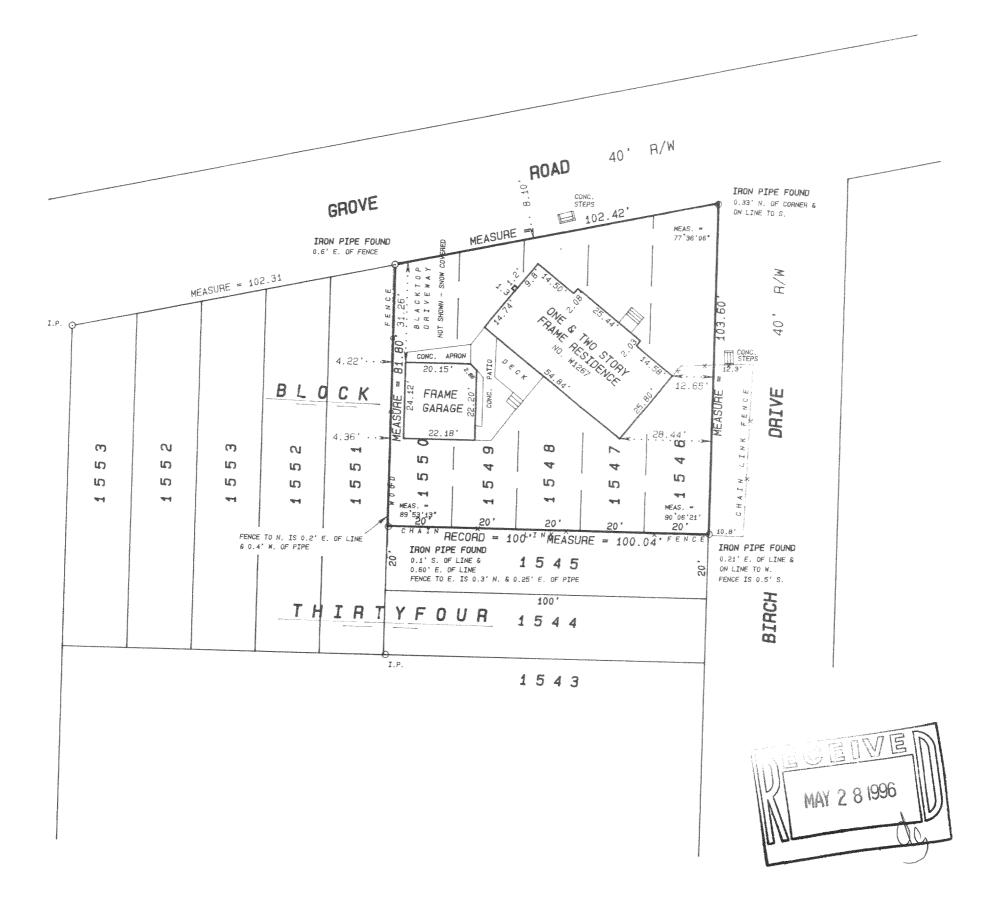

SCALE linch = 30 feet

ORDERED BY B. Limosani / Lake Geneva Properties

JOB NO. 95431

I hereby certify that I have surveyed the above described property and the above plat is a true representation thereof and shows the size and location of the property, its exterior boundaries, the location and dimensions of all visible structures thereon, boundary fences, apparent easements and roadways and visible encrochments, if any.

This survey is made for the exclusive use of the present owners of the property, and also those who purchase, mortgage, or guarantee the title thereto within one year from the date hereof.

Dated at Bassett, Wisconsin this _____day of _____1996.

Mark A. Bolender Wisconsin Registered Land Surveyor S - 1784