


PLAT OF SURVEY
OF

Lot 9 of TUCSANY OF LAKE GENEVA, located in the Northwest Quarter of the Northwest Quarter, the Northeast Quarter of the Northwest Quarter, the Southwest Quarter of the Northwest Quarter of Section 3, Township 1 North of Range 18 East of the 4th Principal Meridian, Township of Bloomfield, Walworth County, Wisconsin.

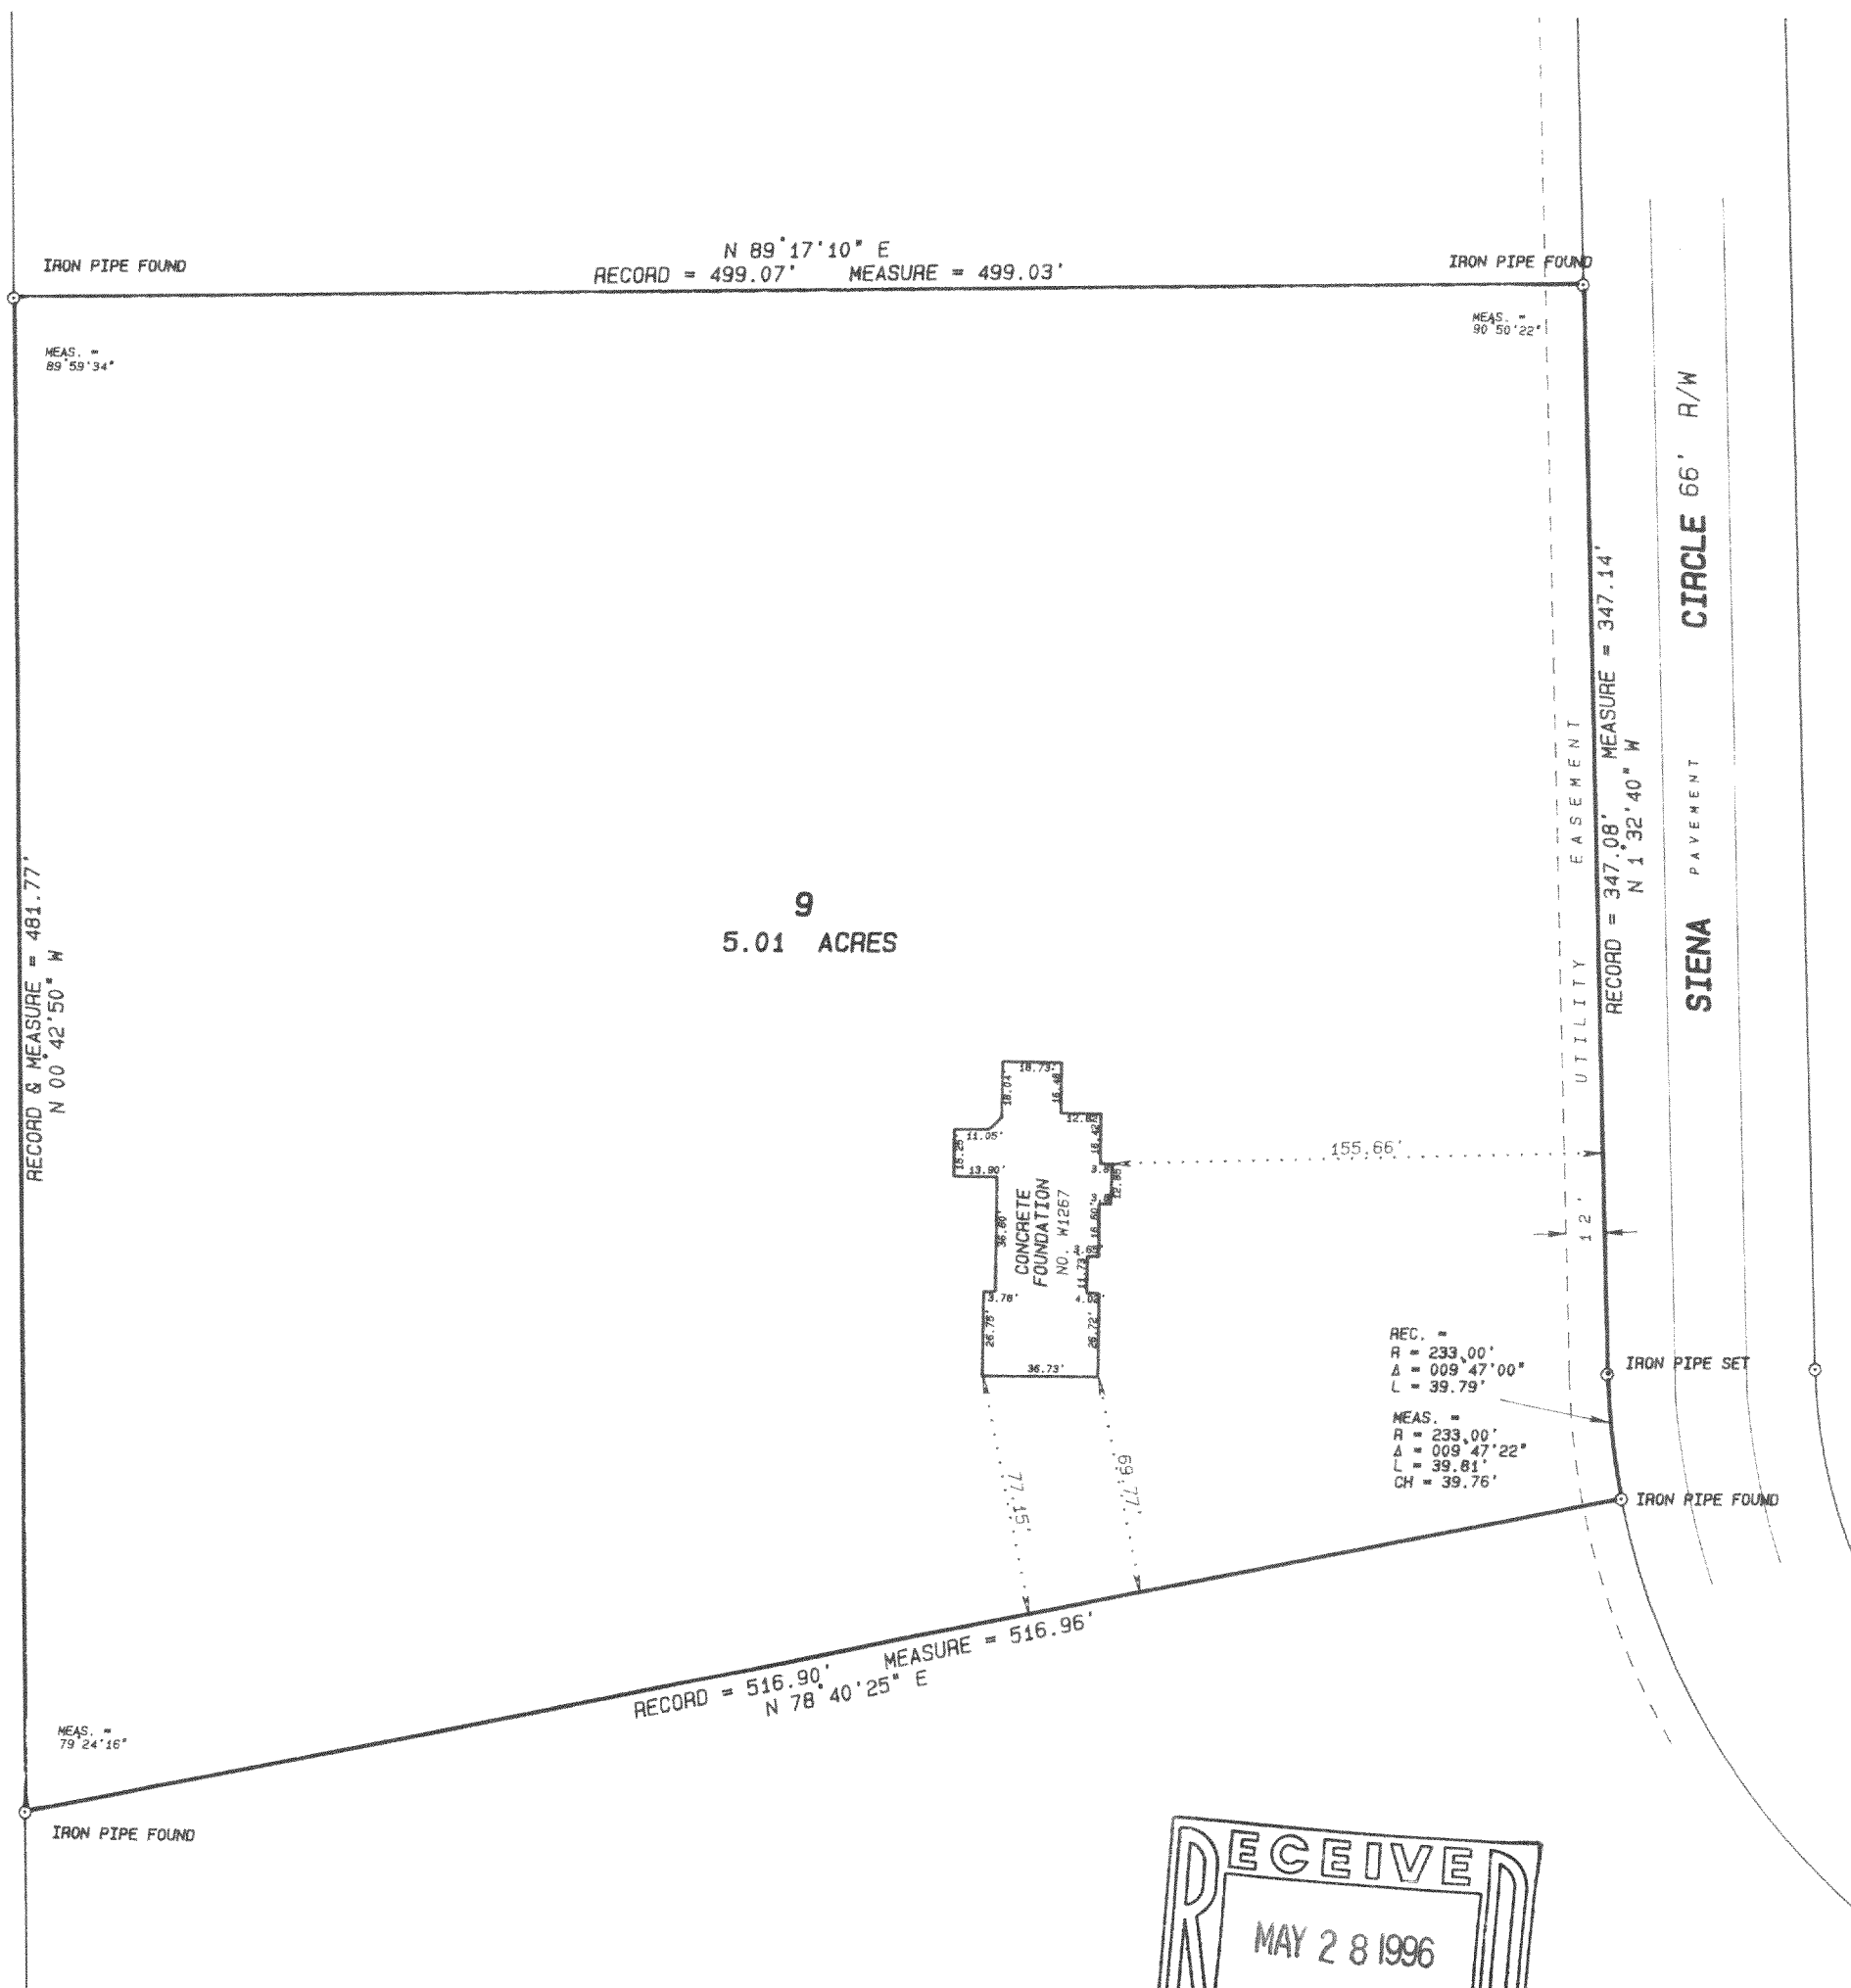

SCALE 1 inch = 60 feet
ORDERED BY L. Mackay / Mackay Construction
JOB NO. 95423

I hereby certify that I have surveyed the above described property and the above plat is a true representation thereof and shows the size and location of the property, its exterior boundaries, the location and dimensions of all visible structures thereon, boundary fences, apparent easements and roadways and visible encroachments, if any.

This survey is made for the exclusive use of the present owners of the property, and also those who purchase, mortgage, or guarantee the title thereto within one year from the date hereof.

Dated at Bassett, Wisconsin this _____ day of _____ 1996.

Mark A. Bolender
Wisconsin Registered Land Surveyor S - 1784

MTU-9
118-1540