


PLAT OF SURVEY

OF

Lots 6090 thru 6092, Block 135 of SECTION 4 OF PELL LAKE, located in part of Section 15, Township 1 North, Range 18 East of the 4th Principal Meridian, Town of Bloomfield, Walworth County, Wisconsin.


NOTE: Concrete curbing along east property line is on line±.

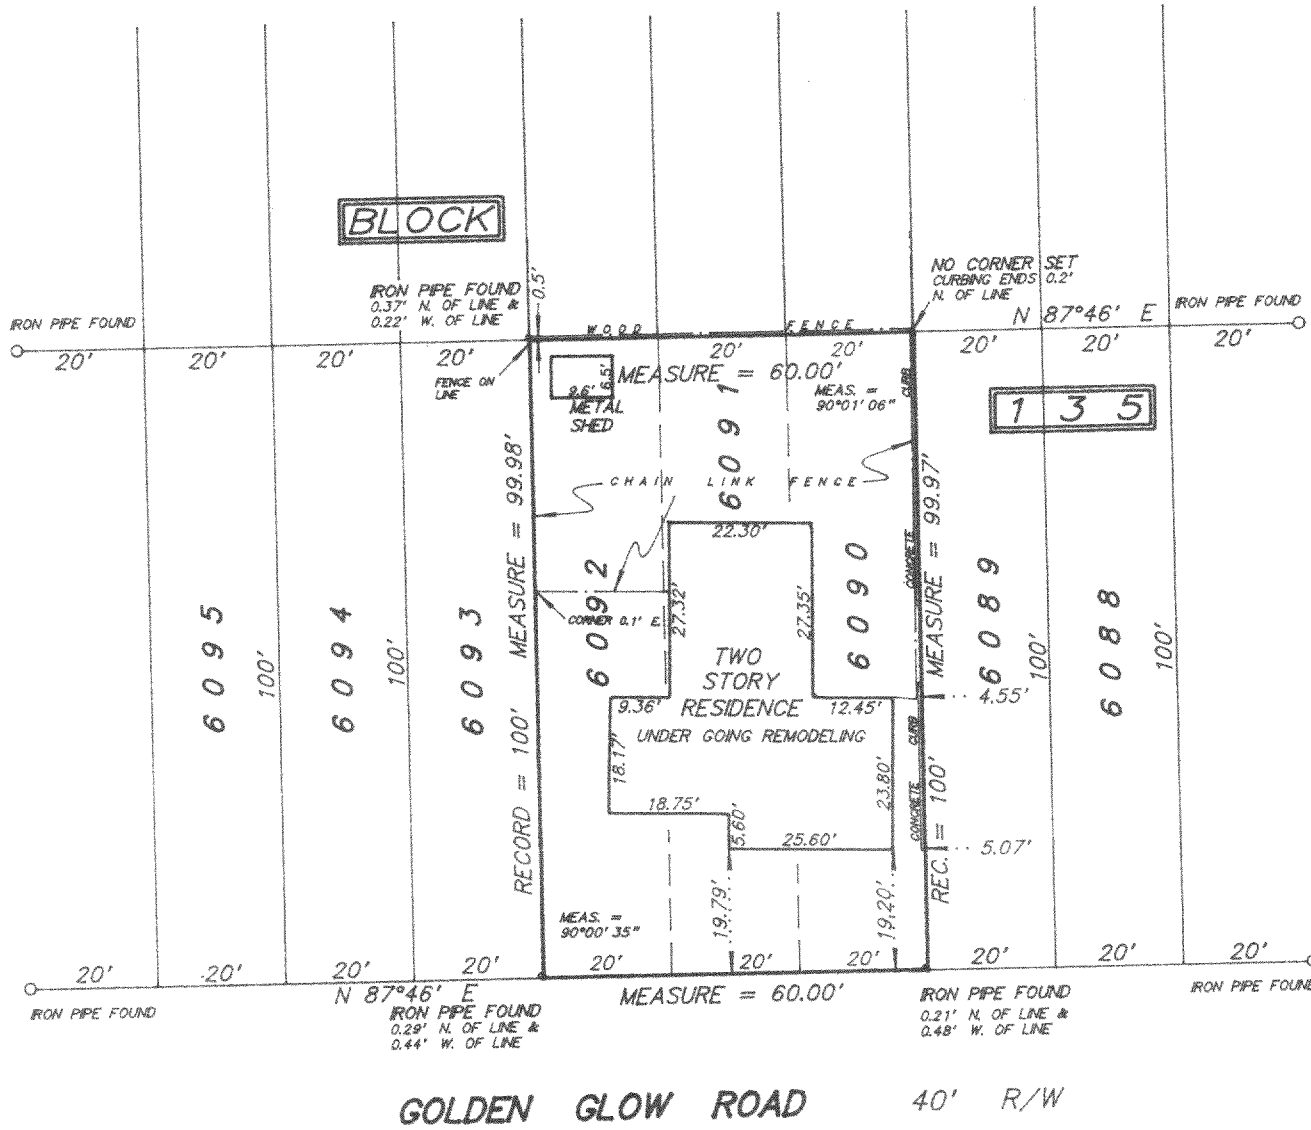

SCALE 1 inch = 30 feet

ORDERED BY J. Turuc

JOB NO. 96359

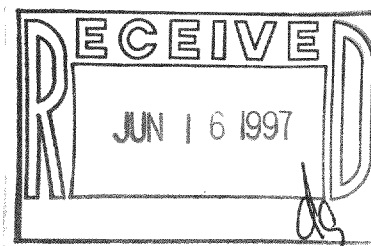

I hereby certify that I have surveyed the above described property and the above plat is a true representation thereof and shows the size and location of the property, its exterior boundaries, the location and dimensions of all visible structures thereon, boundary fences, apparent easements and roadways and visible encroachments, if any.

This survey is made for the exclusive use of the present owners of the property, and also those who purchase, mortgage, or guarantee the title thereto within one year from the date hereof.

Dated at Bassett, Wisconsin this _____ day of _____ 1996.

Mark A. Bolender
Wisconsin Registered Land Surveyor S - 1784