

# PLAT OF SURVEY

PATHFINDER SURVEYING  
929 WILLIAMS ST. LAKE GENEVA, WI.  
(414) 248-3697

ORDERED BY : DEBBIE MILLER  
ERA ACTION REALTY  
204 N. LAKE AVE.  
TWIN LAKES, WI. 53181

DATE: 6/28/1997


DESCRIPTION: LOTS 2487- 2492 INCLUSIVE, PELL LAKE SUBDIVISION, A SUBDIVISION LOCATED IN SECTION 22.,  
T.1.N. , R.18.E. , TOWN OF BLOOMFIELD, WALWORTH COUNTY, WISCONSIN.

OWNERS: GREGORY & ANNA KARPINSKI

## LEGEND

- FOUND 1 IN. IRON PIPE
- FOUND 2 IN. IRON PIPE
- SET 1 IN. IRON PIPE
- x— FENCE


SCALE 1" = 30'

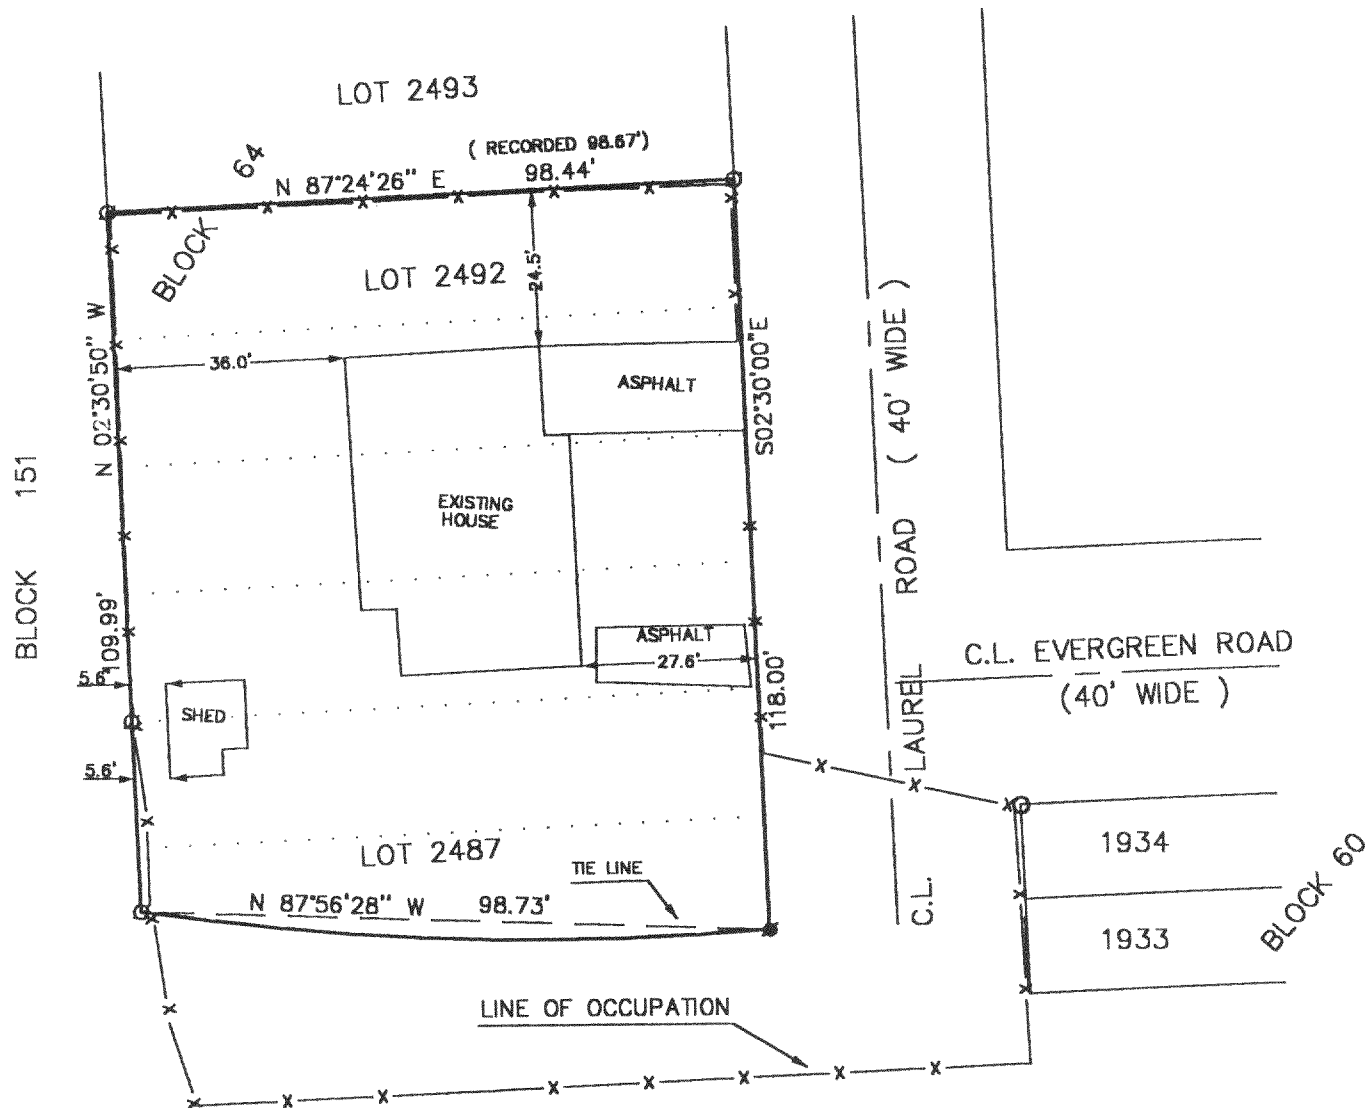


NOTE: BEARINGS REFERENCED TO RECORD PLAT OF PELL LAKE.

THE ABOVE MAP IS A TRUE REPRESENTATION THEREOF AND  
SHOWS THE SIZE AND LOCATION OF ALL THE PROPERTY,  
EXTERIOR BOUNDARIES, THE LOCATION OF ALL VISIBLE  
BOUNDARY FENCES, APPARENT EASEMENTS, ROADWAYS  
AND VISIBLE ENCROACHMENTS, IF ANY.

THIS SURVEY IS MADE FOR THE USE OF THE PRESENT  
OWNERS OF THE PROPERTY, AND ALSO THOSE WHO  
PURCHASE, MORTGAGE OR GUARANTEE TITLE THERETO  
WITHIN ONE (1) YEAR FROM DATE HERETO.

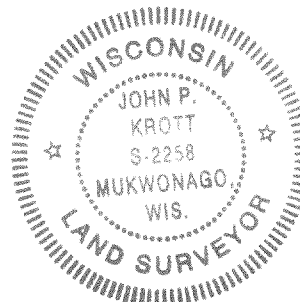

*John P. Krott*  
JOHN P. KROTT, R.L.S. 2258

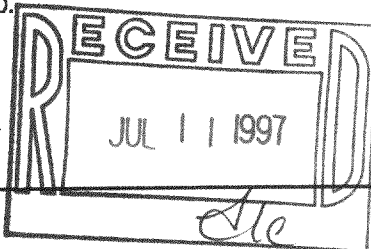

NOTE: THIS IS NOT A CERTIFIED COPY  
UNLESS SEAL IS IN RED

JOB NUMBER 97037/MPL00517

MPL-517  
118-1663