


THE EAST HALF OF LOT 2 AND LOT 3 EXCEPT THE EAST 30 FEET, ALL IN BLOCK 3 OF ROSE NIPPERSINK GARDENS, LOCATED IN THE SE 1/4 AND THE SW 1/4 OF THE SE 1/4 OF SECTION 24, T. 1 N., R. 18 E. OF THE 4TH P.M., TOWNSHIP OF BLOOMFIELD, COUNTY OF WALWORTH, STATE OF WISCONSIN.

BEARING DATUM IS THAT  
OF RECORDED PLAT.

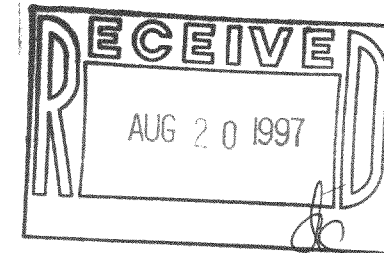

This survey is made for the exclusive use of the present owners of the property, and also those who purchase, mortgage, or guarantee the title thereto, within one year from date hereof.

John F. Degen  
John F. Degen, Land Surveyor S 242  
589 N. Pine St. Burlington, WI 53105  
RE-SURVEYED 4-25-96  
REVISED 2-07-97 SHOW PROP. DWELLING  
REVISED 8-5-97 DWELLING LOCATION.

REVISED 8-15-97 REMOVED