
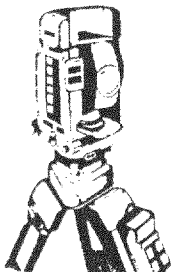


PLAT OF SURVEY
-OF-


LOTS 7113 through 7120, BLOCK 111, PELL LAKE SUBDIVISION, located in Township 1 North, Range 18 East in the Town of Bloomfield, County of Walworth and State of Wisconsin.

Survey For: Century 21 Mueller & Associates
Survey Location: N1241 Walnut Road

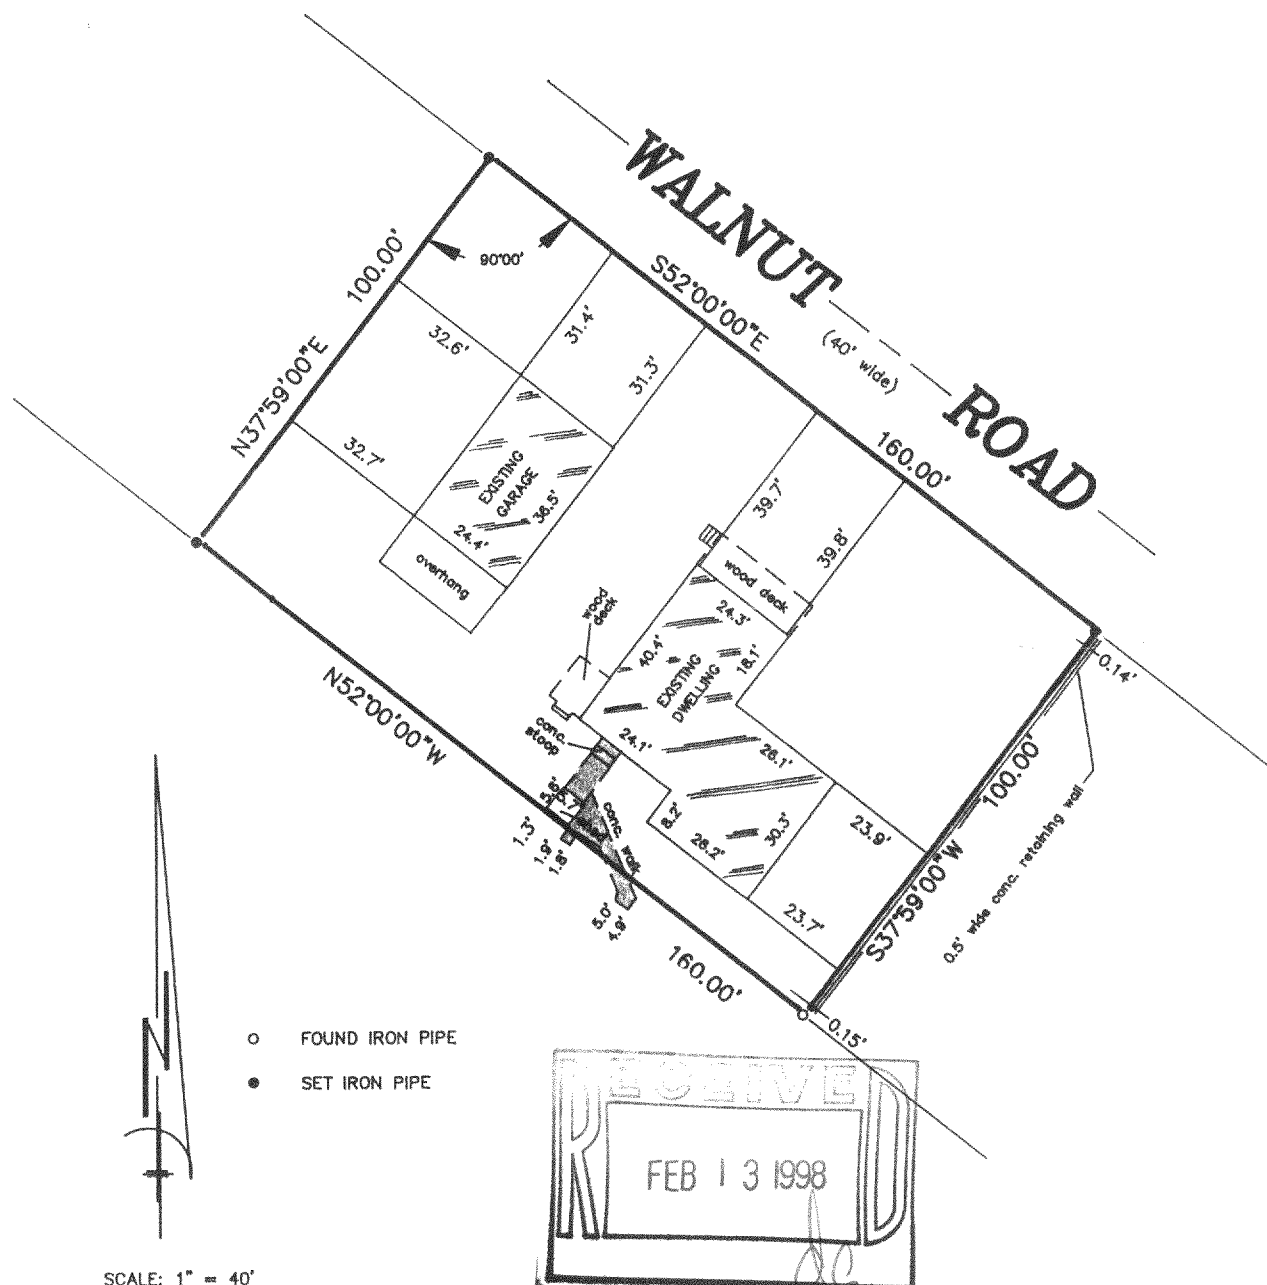

B.W. SURVEYING

Land Surveys
Mapping And Planning
412 N. Pine Street
Burlington, WI 53105
(414) 767-0225

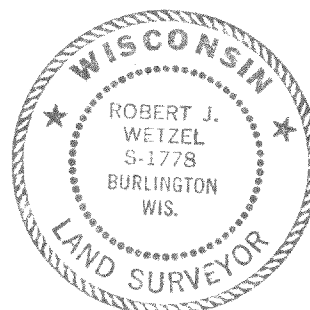

THIS IS NOT AN ORIGINAL PRINT
UNLESS THIS SEAL IS RED

Robert J. Wetzel
ROBERT J. WETZEL
REGISTERED LAND SURVEYOR - 1778

"I hereby certify that I have surveyed the above described property and that the above map is a true representation thereof and shows the size and location of the property, its exterior boundaries, the location of all visible structures and dimensions of all principal buildings thereon, boundary fences, apparent easements, roadways and encroachments, if any."

"This survey is made for the use of the present owners of the property, and those who purchase, mortgage, or guarantee the title thereto within one year from the date hereof."

4/23/97
DATE

2967
JOB NUMBER

MPL-1515

118-1702