PLAT OF SURVEY


PATHFINDER SURVEYING FORMERLY KOLB LAND CONSULTING 929 WILLIAMS ST. LAKE GENEVA, WI. (414) 248-3697

ORDERED BY : PHILIP CALANDRA

28116 ROBERTS ROAD BEARINGTON, IL. 60010 DATE: 2 / 24 / 1998

DESCRIPTION: LOTS 2380-2383, BLOCK 56 OF SECTION 2 OF PELL LAKE SUBDIVISION, LOCATED IN SECTION 22,

T.1.N., R.18.E, WALWORTH COUNTY, WISCONSIN.

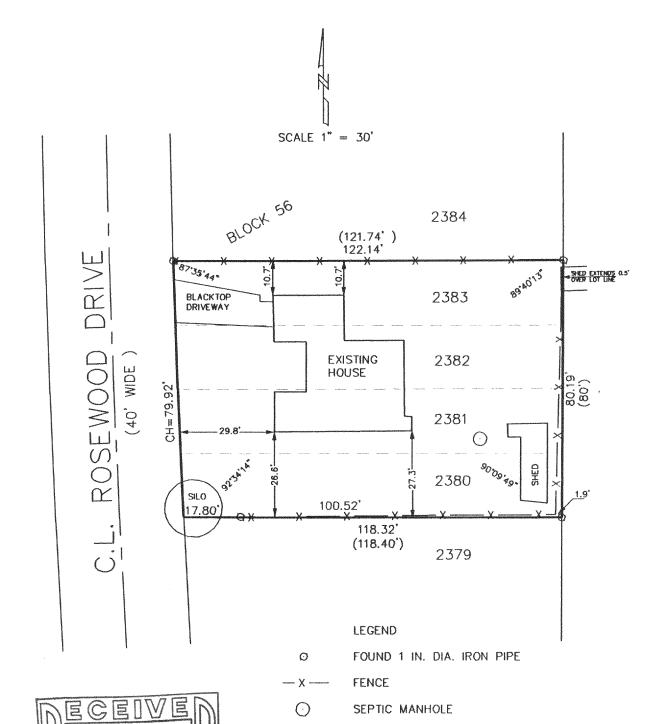

(XXXX)

RECORDED AS

THE ABOVE MAP IS A TRUE REPRESENTATION THEREOF AND SHOWS THE SIZE AND LOCATION OF ALL THE PROPERTY, EXTERIOR BOUNDARIES, THE LOCATION OF ALL VISIBLE BOUNDARY FENCES, APPARENT EASEMENTS, ROADWAYS AND VISIBLE ENCROACHMENTS, IF ANY.

THIS SURVEY IS MADE FOR THE USE OF THE PRESENT OWNERS OF THE PROPERTY, AND ALSO THOSE WHO PURCHASE, MORTGAGE OR GURANTEE TITLE THERETO WITHIN ONE (1) YEAR FROM DATE HERETO.

MAR 2 7 1998

JOHN P. KROTT, R.L.S. 2258



NOTE: THIS IS NOT A CERTIFIED COPY UNLESS SEAL IS IN RED. JOB NUMBER 1-18-MPL-493/98019

118-170