PLAT OF SURVEY

LOTS 5489 THRU 5496, BLOCK 100 OF
SECTION 3 PELL LAKE SUBDIVISION
LOCATED IN SECTION 15, TOWN 1 NORTH, RANGE 18 EAST
TOWN OF BLOOMFIELD, WALWORTH COUNTY, WISCONSIN


ASPHALT PAVEMENT



FARRIS, HANSEN & ASSOC. INC. ENGINEERS • SURVEYORS • ARCHITECTS

7 Ridgway Court P.O. Box 437 Elkhorn, Wl. 53121 Tel. 414-723-2098 Fax. 414-723-5886 Proj No. 5378 Date: 08/30/99

PREPARED FOR: FRANK GARDNER

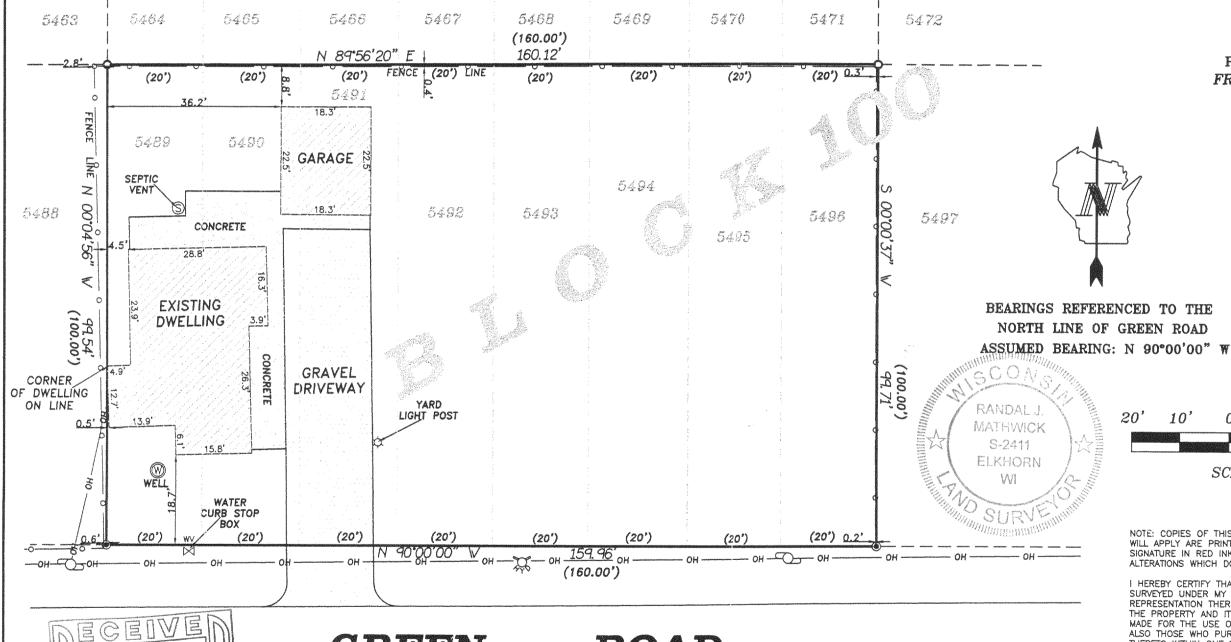

LEGEND

O - FOUND IRON PIPE

O POWER POLE

---- OVERHEAD WIRES

C - HYDRANT

) - RECORDED AS

20' 10' 0 20' 40'

SCALE: 1" = 20

NOTE: COPIES OF THIS MAP TO WHICH THE FOLLOWING CERTIFICATE WILL APPLY ARE PRINTS SHOWING SURVEYOR'S ORIGINAL SEAL AND SIGNATURE IN RED INK. COPIES BY ANY OTHER MEANS MAY HAVE ALTERATIONS WHICH DO NOT REPRESENT THE SURVEYOR'S WORK PRODUCT.

I HEREBY CERTIFY THAT THE ABOVE DESCRIBED PROPERTY HAS BEEN SURVEYED UNDER MY DIRECTION AND THAT THE ABOVE MAP IS A TRUE REPRESENTATION THEREOF AND SHOWS THE SIZE AND LOCATION OF THE PROPERTY AND ITS EXTERIOR BOUNDARIES. THIS SURVEY IS MADE FOR THE USE OF THE PRESENT OWNERS OF THE PROPERTY, AND ALSO THOSE WHO PURCHASE, MORTGAGE, OR GUARANTEE THE TITLE THERETO WITHIN ONE YEAR FROM THE DATE HEREOF.

DATED: AUGUST 30, 1999

RANDAL J. MATHWICK

R.L.S. 2411

GREEN

N ROAD
(40' WIDE R.O.W.)

0