PLAT OF SURVEY

PATHFINDER SURVEYING FORMERLY KOLB LAND CONSULTING 929 WILLIAMS STREET LAKE GENEVA, WI. 53147 (414) 248-3697

ORDERED BY:

BRADEN & OLSON


716 WISCONSIN LAKE GENEVA, WI. 53147 DATE: 7-7-1999

DESCRIPTION:

LOTS 1721 THRU 1728 BLOCK 23 OF PELL LAKE HIGHLANDS, A SUBDIVISON LOCATED IN SECTION 18, T1N, R18E, TOWN OF BLOOMFIELD, WALWORTH COUNTY, WISCONSIN.



C.L. EASTWOOD ROAD (40') WIDE

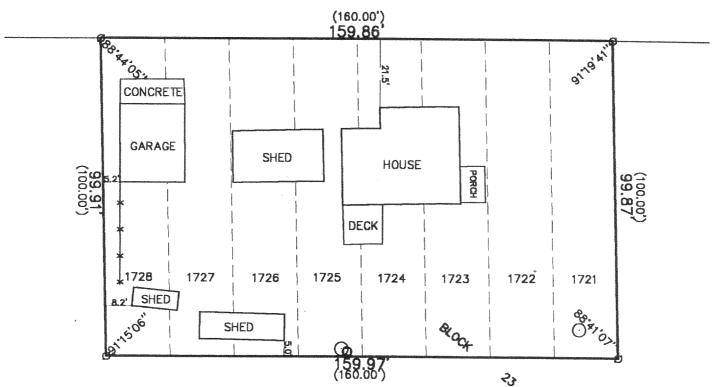



LEGEND

Ø FOUND IRON PIPE

MANHOLE

(XXX) RECOEDED AS

O VENT

WELL

THE ABOVE MAP IS A TRUE REPRESENTATION THEREOF AND SHOWS THE SIZE AND LOCATION OF ALL THE PROPERTY, EXTERIOR BOUNDARIES, THE LOCATION OF ALL VISIBLE BOUNDARY FENCES, APPARENT EASEMENTS, ROADWAYS AND VISIBLE ENCROACHMENTS, IF ANY

THIS SURVEY IS MADE FOR THE USE OF THE PRESENT OWNERS OF THE PROPERTY, AND ALSO THOSE WHO PURCHASE, MORTGAGE OR GURANTEE TITLE THERETO WITHIN ONE (1) YEAR FROM DATE HERETO.

JOHN P. KROTT , R.L.S. 2258



NOTE: THIS IS NOT A CERTIFIED COPY
UNLESS SEAL IS IN RED.
JOB NUMBER 88140 1-18 MPLH 0303

118-1851