


PLAT OF SURVEY
 OF

FAX 414-537-4221

RECEIVED
JAN 7 2000

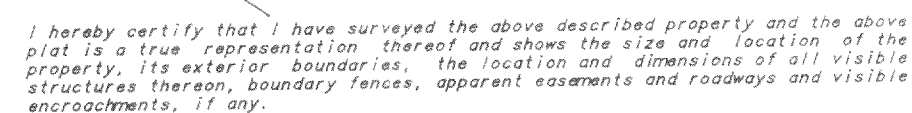

This survey is made for the exclusive use of the present owners of the property, and also those who purchase, mortgage, or guarantee the title thereto within one year from the date hereof.

Dated at Bassett, Wisconsin this _____ day of _____ 1999.

Mark A. Bolender
Wisconsin Registered Land Surveyor S - 1784

SCALE 1 inch = 30 feet

ORDERED BY *New Homes By Dennis*

JOB NO. 99080

118-1891
MMH-27