## PLAT OF SURVEY

## PATHFINDER SURVEYING


FORMERLY KOLB LAND CONSULTING 929 WILLIAMS STREET LAKE GENEVA, W. 53147 (262) 248-3697

ORDERED BY: PATRICA DADE

PATRICA DADE N 1182 COUNTY RD H GENOA CITY, WI. 53128 DATE: 3-31-2000

DESCRIPTION:

LOTS 186 THRU 193, AND THE SOUTHWESTERLY 8.80
FEET OF LOTS 162 AND 163, ALL IN BLOCK 3, OF PELL LAKE

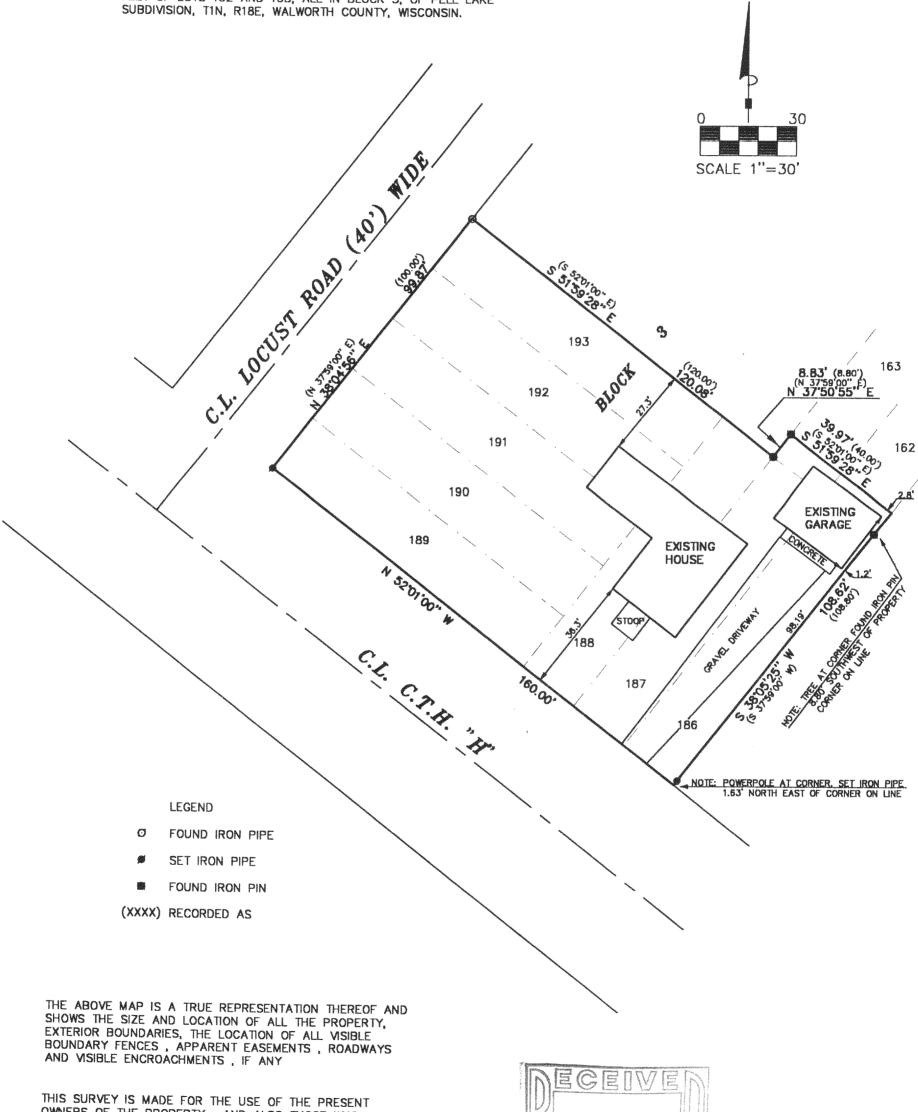

THIS SURVEY IS MADE FOR THE USE OF THE PRESENT OWNERS OF THE PROPERTY . AND ALSO THOSE WHO PURCHASE . MORTGAGE OR GURANTEE TITLE THERETO WITHIN ONE (1) YEAR FROM DATE HERETO.



NOTE: THIS IS NOT A CERTIFIED COPY

JOB NUMBER # 00063 1-18-MPL 00043

JOHN P. KROTT , R.L.S. 2258

MPL-43 MPL-35A