



PLAT OF SURVEY

PATHFINDER SURVEYING
FORMERLY KOLB LAND CONSULTING
929 WILLIAMS STREET LAKE GENEVA, WI. 53147
(262) 248-3697

ORDERED BY: PATRICA DADE
N 1182 COUNTY RD H
GENOA CITY, 53128 WI.

DATE: 3-31-2000

DESCRIPTION: LOTS 186 THRU 193, AND THE SOUTHWESTERLY 8.80
FEET OF LOTS 162 AND 163, ALL IN BLOCK 3, OF PELL LAKE
SUBDIVISION, T1N, R18E, WALWORTH COUNTY, WISCONSIN.

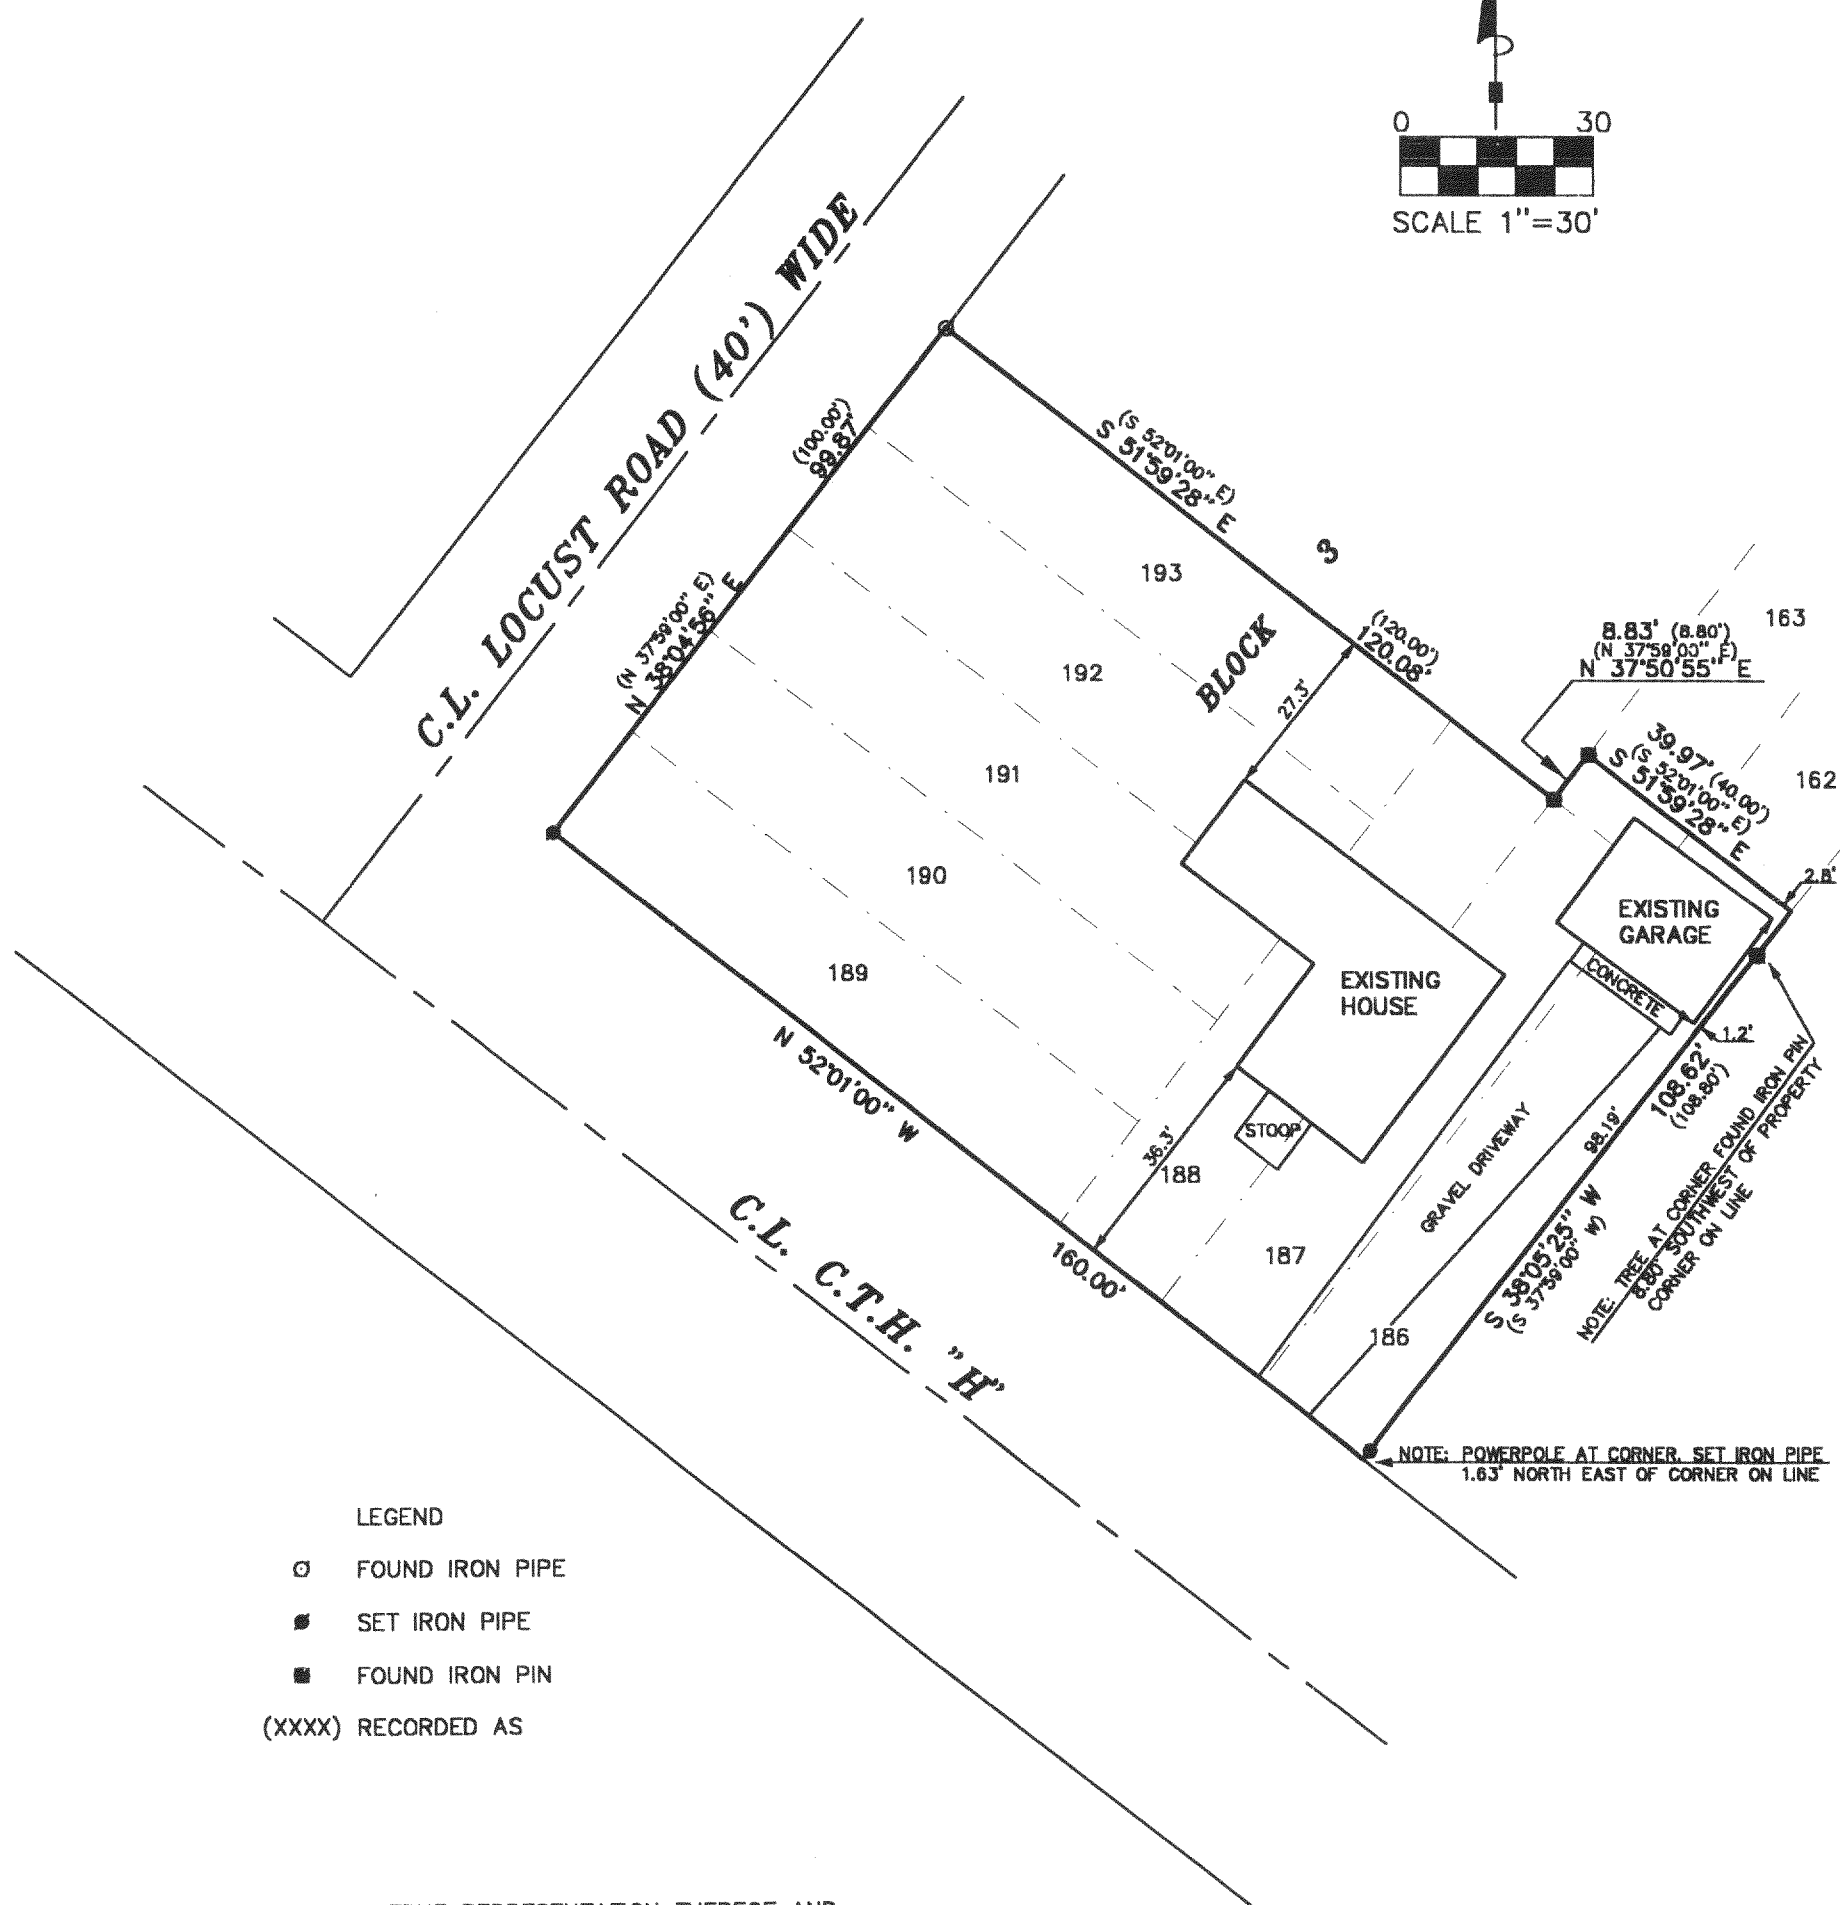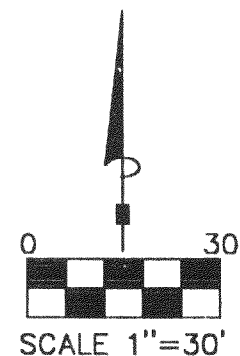

LEGEND



- FOUND IRON PIPE
- SET IRON PIPE
- FOUND IRON PIN

(XXXX) RECORDED AS

THE ABOVE MAP IS A TRUE REPRESENTATION THEREOF AND
SHOWS THE SIZE AND LOCATION OF ALL THE PROPERTY,
EXTERIOR BOUNDARIES, THE LOCATION OF ALL VISIBLE
BOUNDARY FENCES, APPARENT EASEMENTS, ROADWAYS
AND VISIBLE ENCROACHMENTS, IF ANY

THIS SURVEY IS MADE FOR THE USE OF THE PRESENT
OWNERS OF THE PROPERTY, AND ALSO THOSE WHO
PURCHASE, MORTGAGE OR GUARANTEE TITLE THERETO
WITHIN ONE (1) YEAR FROM DATE HERETO.

John P. Krott
JOHN P. KROTT, R.L.S. 2258

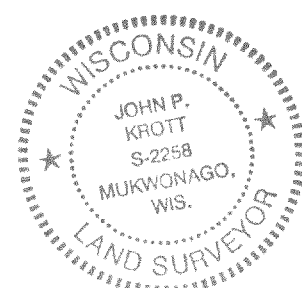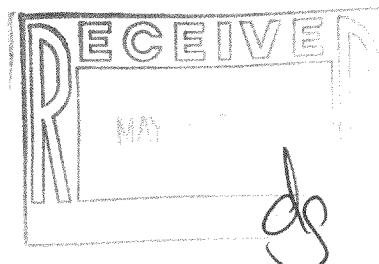

NOTE: THIS IS NOT A CERTIFIED COPY
UNLESS SEAL IS IN RED.

JOB NUMBER # 00063 1-18-MPL 00043

118-1936

MPL-43