
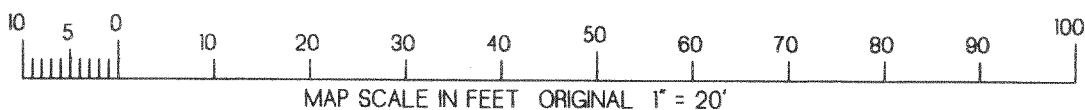


FARRIS, HANSEN, & ASSOCIATES, INC.
ENGINEERING, ARCHITECTURE, SURVEYING
7 RIDGWAY COURT - P.O. BOX 437, ELKHORN, WISCONSIN, 53121
PHONE: (414) 723-2098 FAX: (414) 723-5886
PLAT OF SURVEY

**LOT 25 OF WILLOW ESTATES, A SUBDIVISION
LOCATED IN PART OF THE SE 1/4 OF THE NE 1/4
OF SECTION 15, TOWN 1 NORTH, RANGE 18 EAST,
WALWORTH COUNTY, WISCONSIN**

- WORK ORDERED BY -
DENNIS UNBEHAUN
N 1945 DAISY DRIVE
GENOA CITY, WISCONSIN

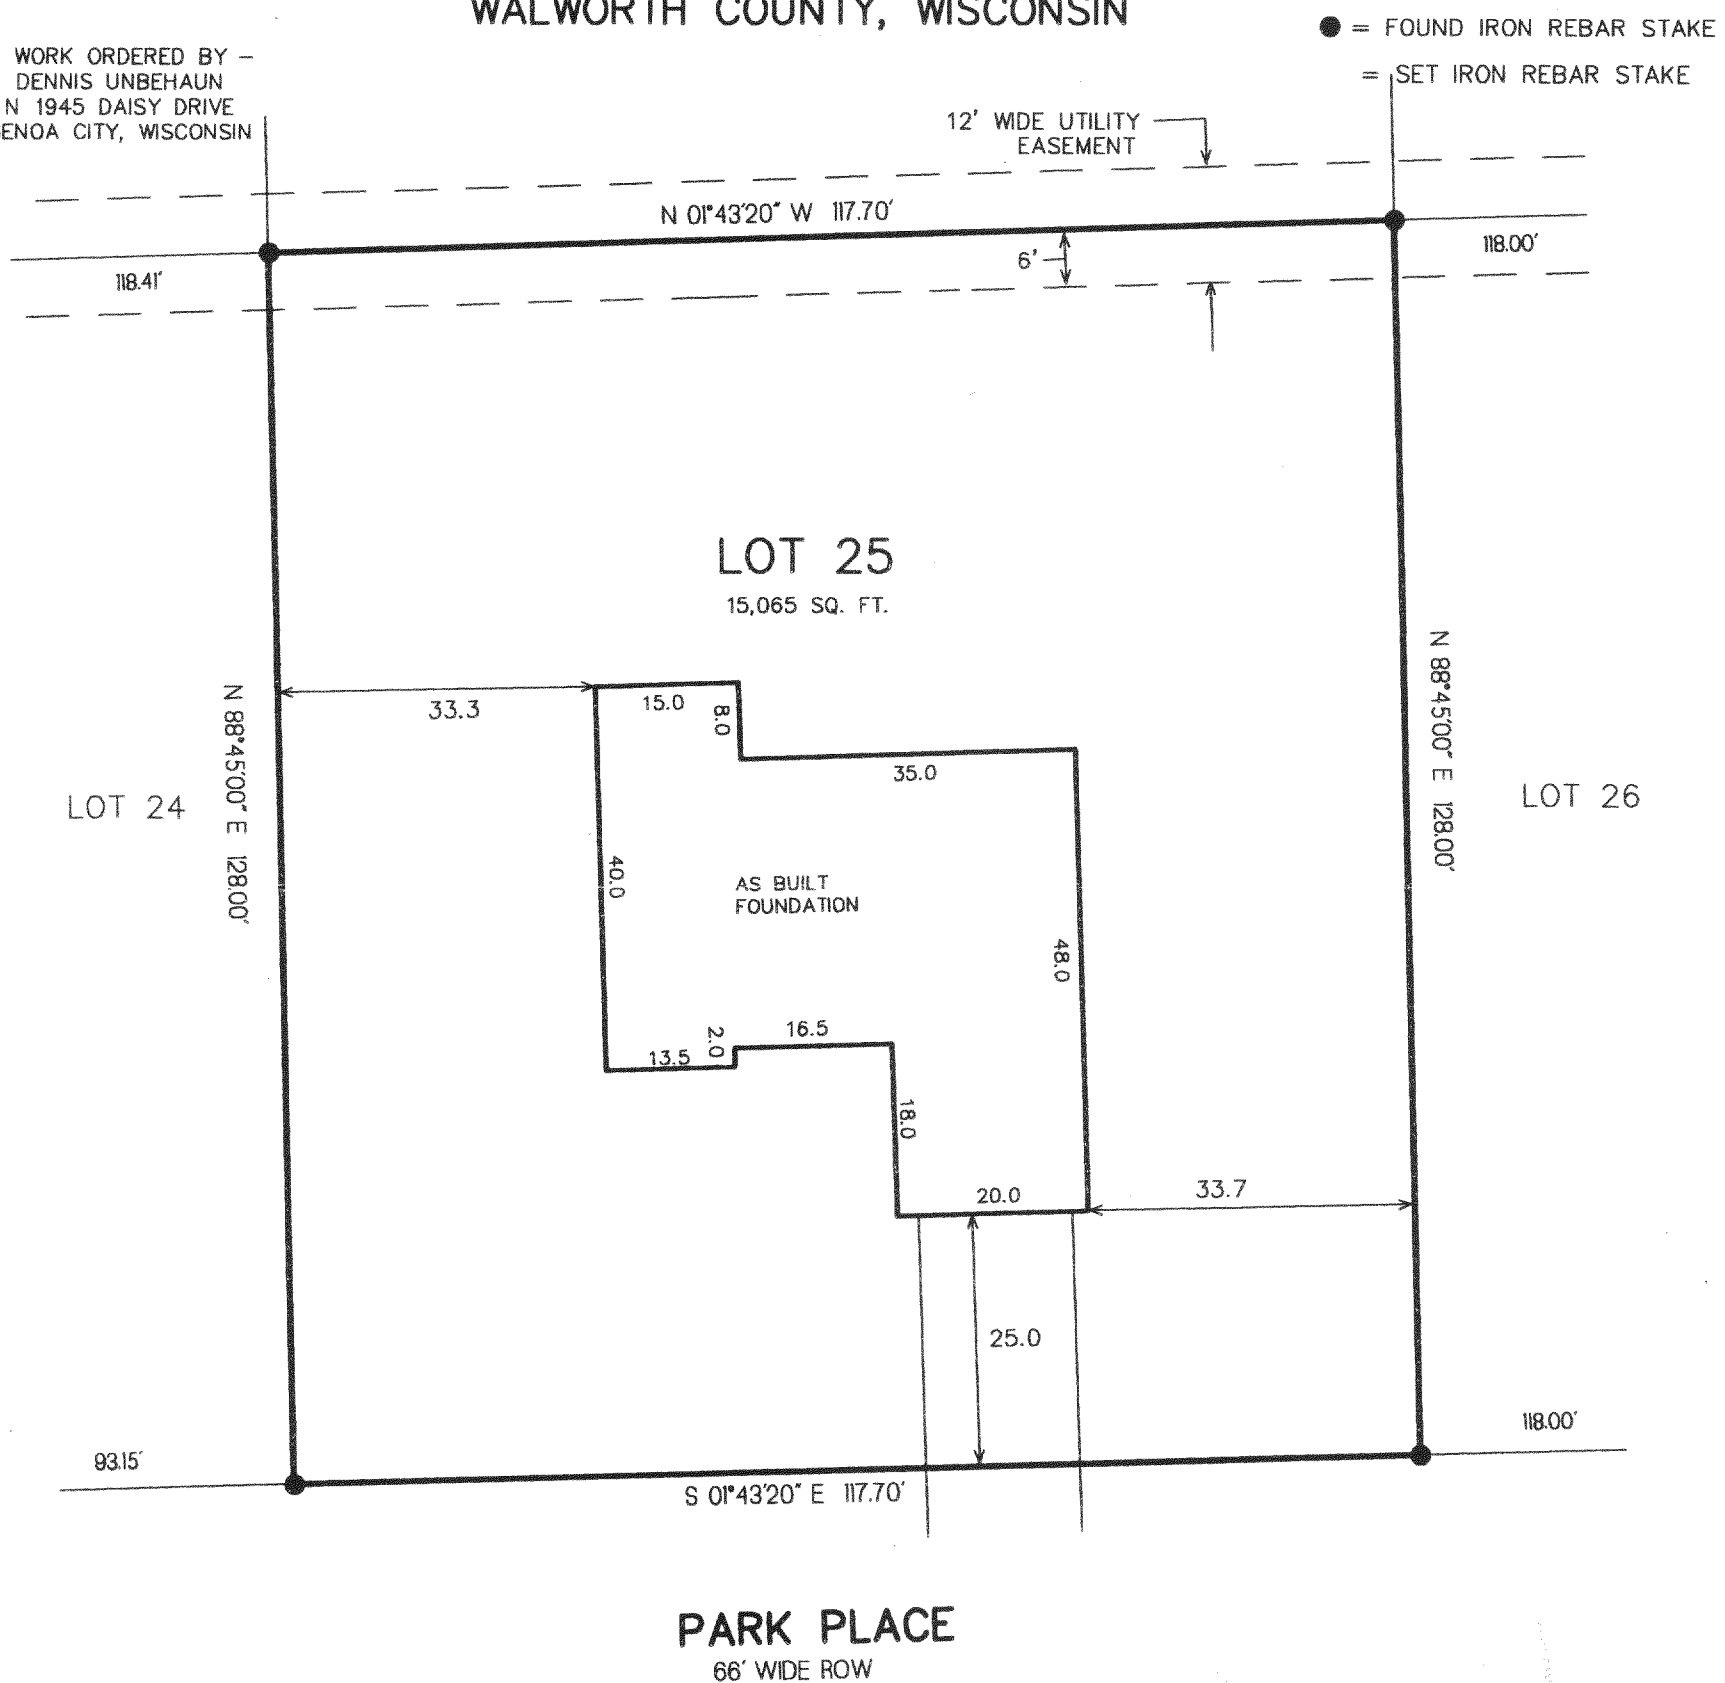


NOTE: COPIES OF THIS MAP TO WHICH THE FOLLOWING CERTIFICATE WILL APPLY SHOW
SURVEYOR'S ORIGINAL SEAL AND SIGNATURE IN RED INK. COPIES BY ANY OTHER MEANS MAY HAVE ALTERATIONS
WHICH DO NOT REPRESENT THE SURVEYOR'S WORK PRODUCT.

I HEREBY CERTIFY THAT THE ABOVE DESCRIBED PROPERTY HAS BEEN SURVEYED UNDER MY DIRECTION AND THAT THE
ABOVE MAP IS A TRUE REPRESENTATION THEREOF AND SHOWS THE SIZE AND LOCATION OF THE PROPERTY AND ITS
EXTERIOR BOUNDARIES. THIS SURVEY IS MADE FOR THE USE OF THE PRESENT OWNERS OF THE PROPERTY, AND
ALSO THOSE WHO PURCHASE, MORTGAGE, OR GUARANTEE THE TITLE THERETO WITHIN ONE YEAR FROM THE DATE
HEREOF.

DATED: 2/25/2000

Peter S. Gordon
PETER S. GORDON R.L.S. 2101

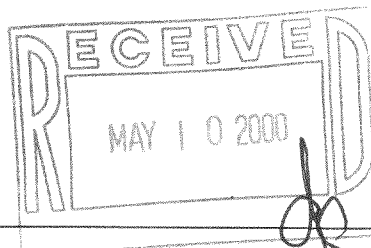

ASSIGNED E. LINE NE 1/4
S 01°42'25" E

PROJECT 4886.25
DATE: 01-20-2000
SHEET 1 OF 1

MWE-25

118-1934