


- OF -

J.K. SURVEYING
JEFFREY L. KIMPS R.L.S.
7561 336TH AVE
BURLINGTON WI. 53105
414-537-4274

PROPERTY ADDRESS
875 PRIMROSE

PRIMROSE

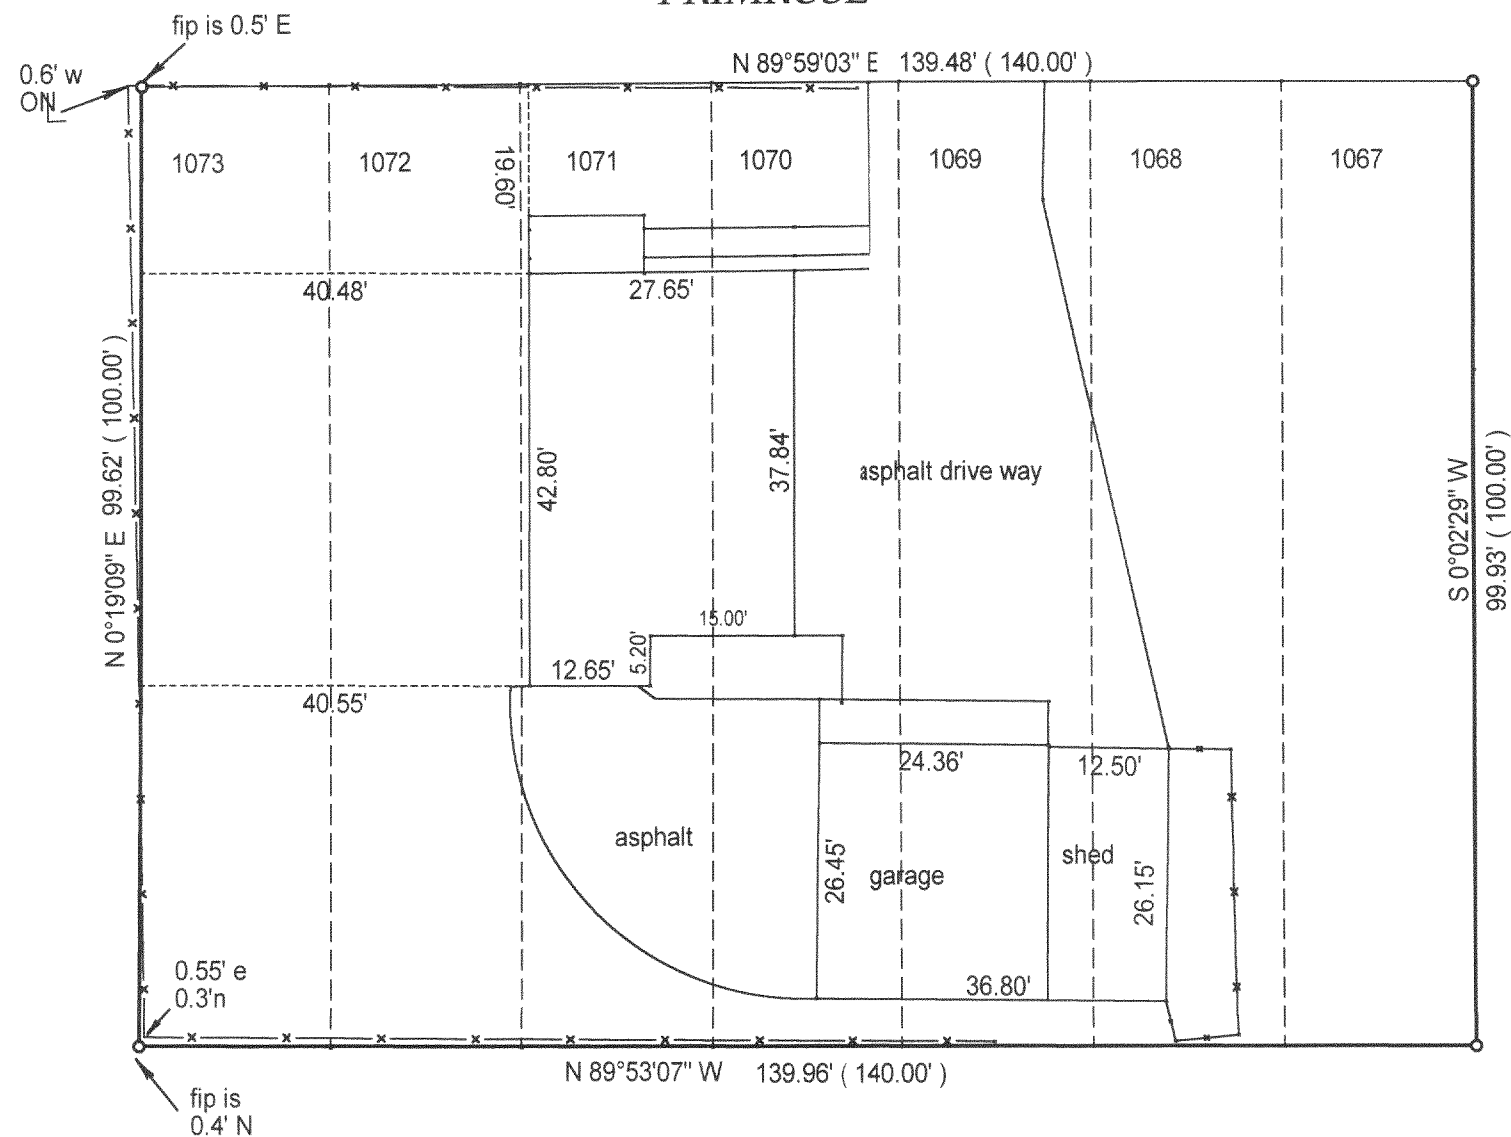

() = recorded as
 ■ = set iron bar
 □ = found iron bar
 ○ = found iron pipe
 ● = set iron pipe

SCALE 1" = 20'

JOB # 00-182C

TAX ID # MPLA 00219


COMPARE LEGAL DESCRIPTION ABOVE AND DRAWING WITH DEED. FOR BUILDING RESTRICTIONS AND EASEMENTS NOT SHOWN, REFER TO DEED, ABSTRACT SOURCES AND LOCAL MUNICIPAL CODES. NOTIFY THE SURVEYOR IMMEDIATELY OF ANY DISCREPANCY.

"I hereby certify that I have surveyed the above described property and that the above map is a true representation thereof and shows the size and location of all visible structures, apparent easements and encroachments if any."

This survey is made for the present owners of the property, and those who purchase, mortgage, or guarantee the title thereto, within one year from the date hereof.

DATED THIS 13 TH, DAY OF MAY 20 00

A decorative vertical line with a stylized 'S' shape. To the right of the line is a 'RECEIVED' stamp dated JUN 19 2000. The stamp is tilted and has a hand-drawn arrow pointing to the date. The word 'NORTH' is written vertically along the left side of the line.


JEFFREY L KIMPS S2436
(original if signed in red)

MPLA-219

118-1937