
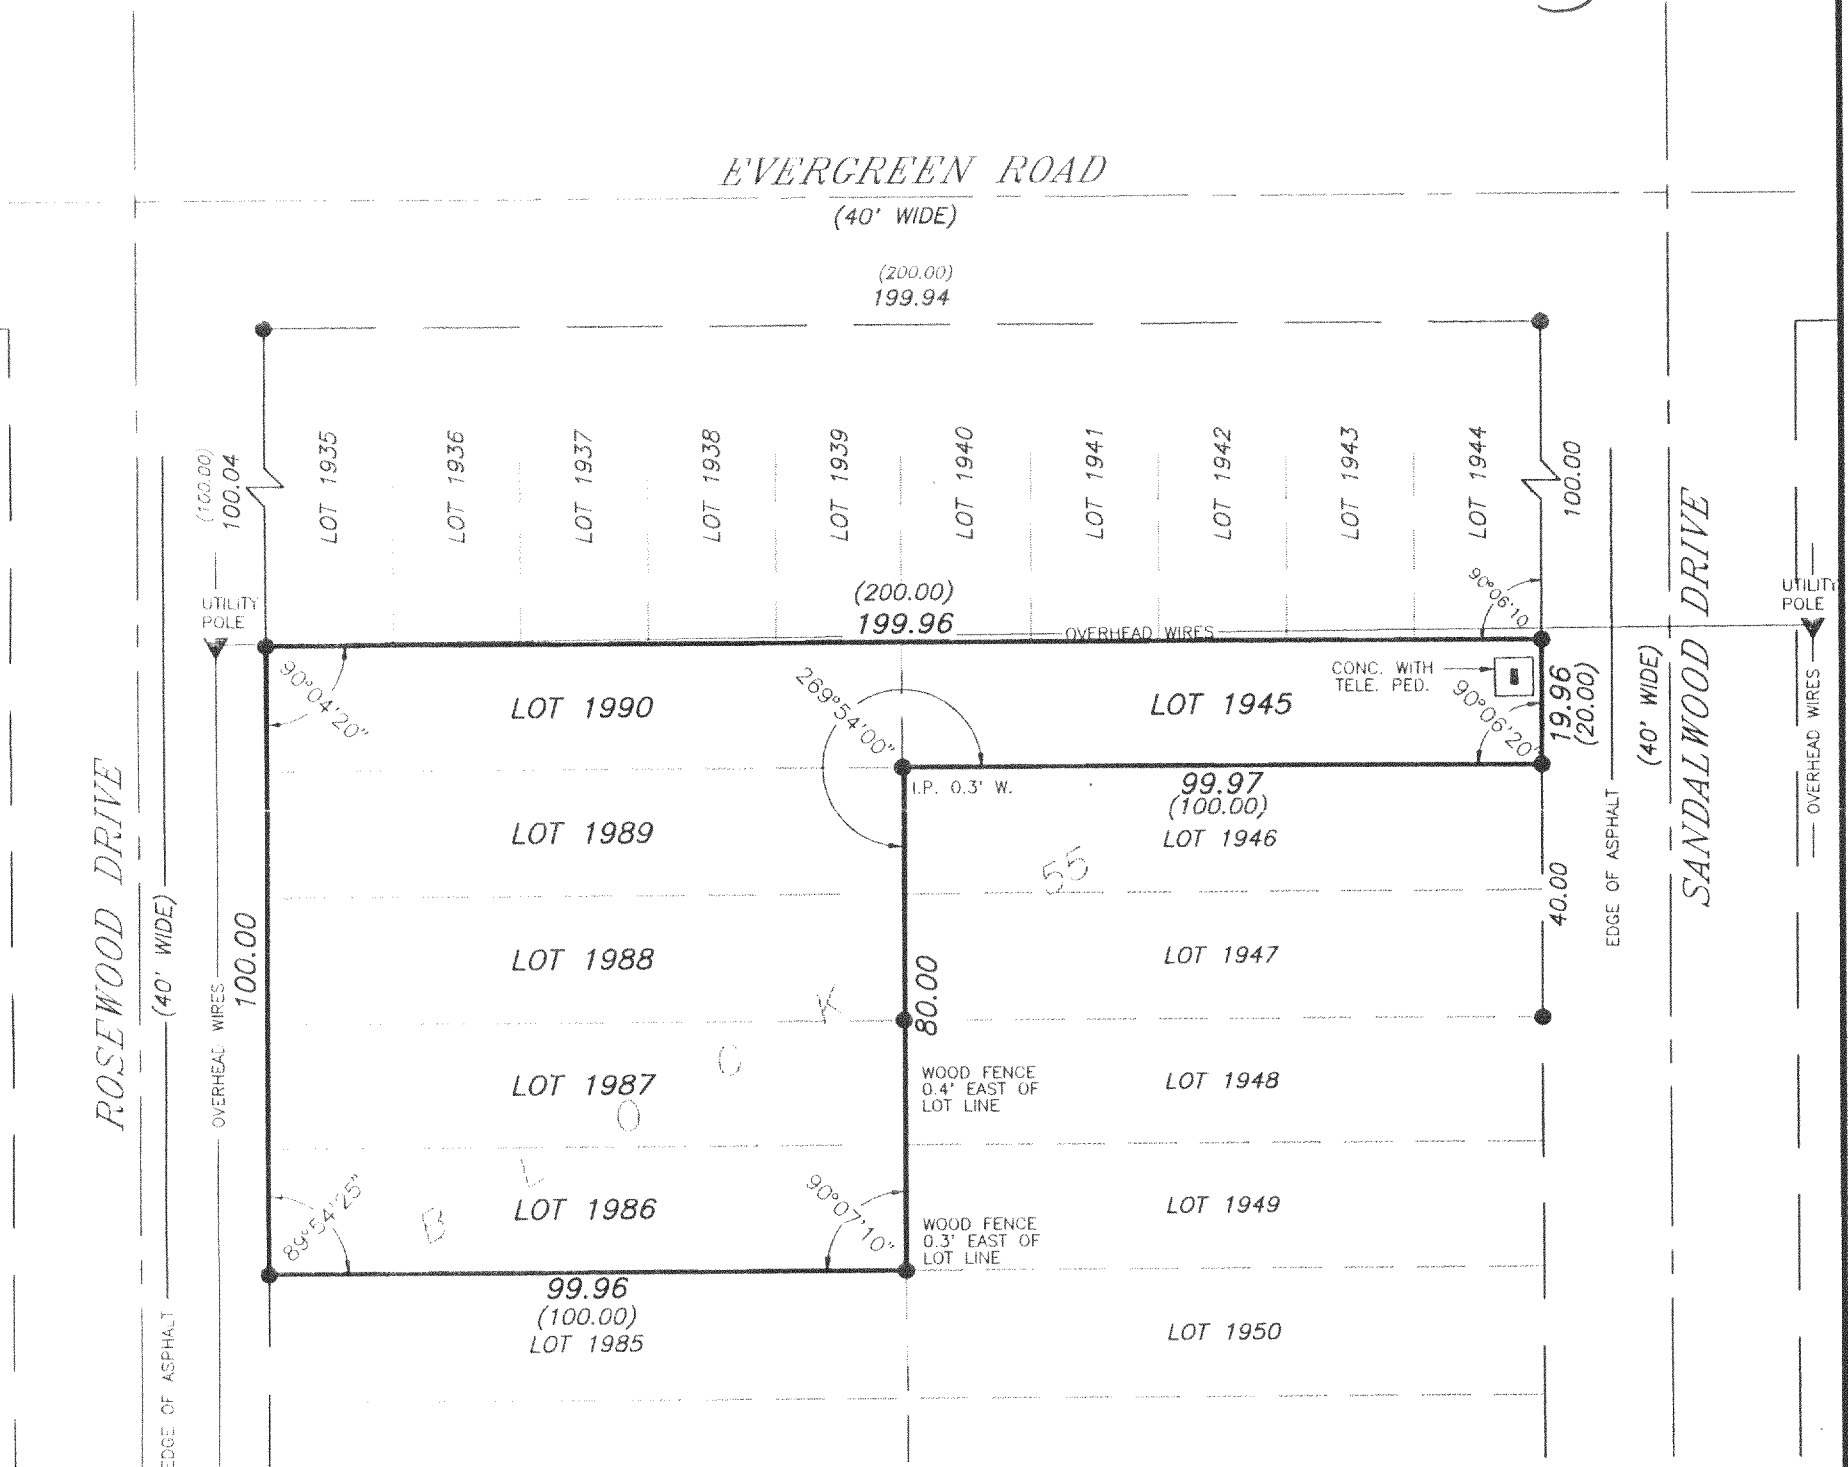


004190  
004190S1.DWG

# PLAT OF SURVEY

SURVEY PREPARED FOR: VICKIE PEIFFER  
COLDWELL BANKER  
LAKE & COUNTRY, REALTORS  
336 E. MAIN STREET  
TWIN LAKES, WISCONSIN 53181

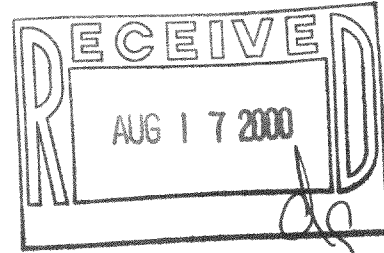

### LEGEND

- - FOUND IRON PIPE  
 x---x--- - FENCE  
 ( ) - RECORDED AS

I HEREBY CERTIFY THAT I HAVE SURVEYED THE ABOVE DESCRIBED PROPERTY AND THE ABOVE MAP IS A TRUE REPRESENTATION THEREOF AND SHOWS THE SIZE AND LOCATION OF THE PROPERTY, THE LOCATION OF ALL VISIBLE STRUCTURES AND DIMENSIONS OF ALL PRINCIPAL BUILDINGS THEREON, BOUNDARY FENCES, APPARENT EASEMENTS, ROADWAY AND VISIBLE ENCROACHMENTS, IF ANY.

THIS SURVEY IS MADE FOR THE PRESENT OWNERS OF THE PROPERTY, AND ALSO THOSE WHO PURCHASE, OR GUARANTEE THE TITLE THERE TO WITHIN (1) YEAR FROM THE DATE HEREOF.

DATED AT WATERFORD, WI THIS 7th DAY OF JUNE 2000

RECERTIFIED.

WISCONSIN

GARY B.  
FOAT  
S-1598  
Waterford,  
Wis.

LAND SURVEYOR

MPL-431

118-1948

MPL-431