


004228  
004228S1.DWG

PLAT OF SURVEY

SURVEY PREPARED FOR: RICH KAROW  
8155 400TH AVENUE  
BURLINGTON, WI 53105

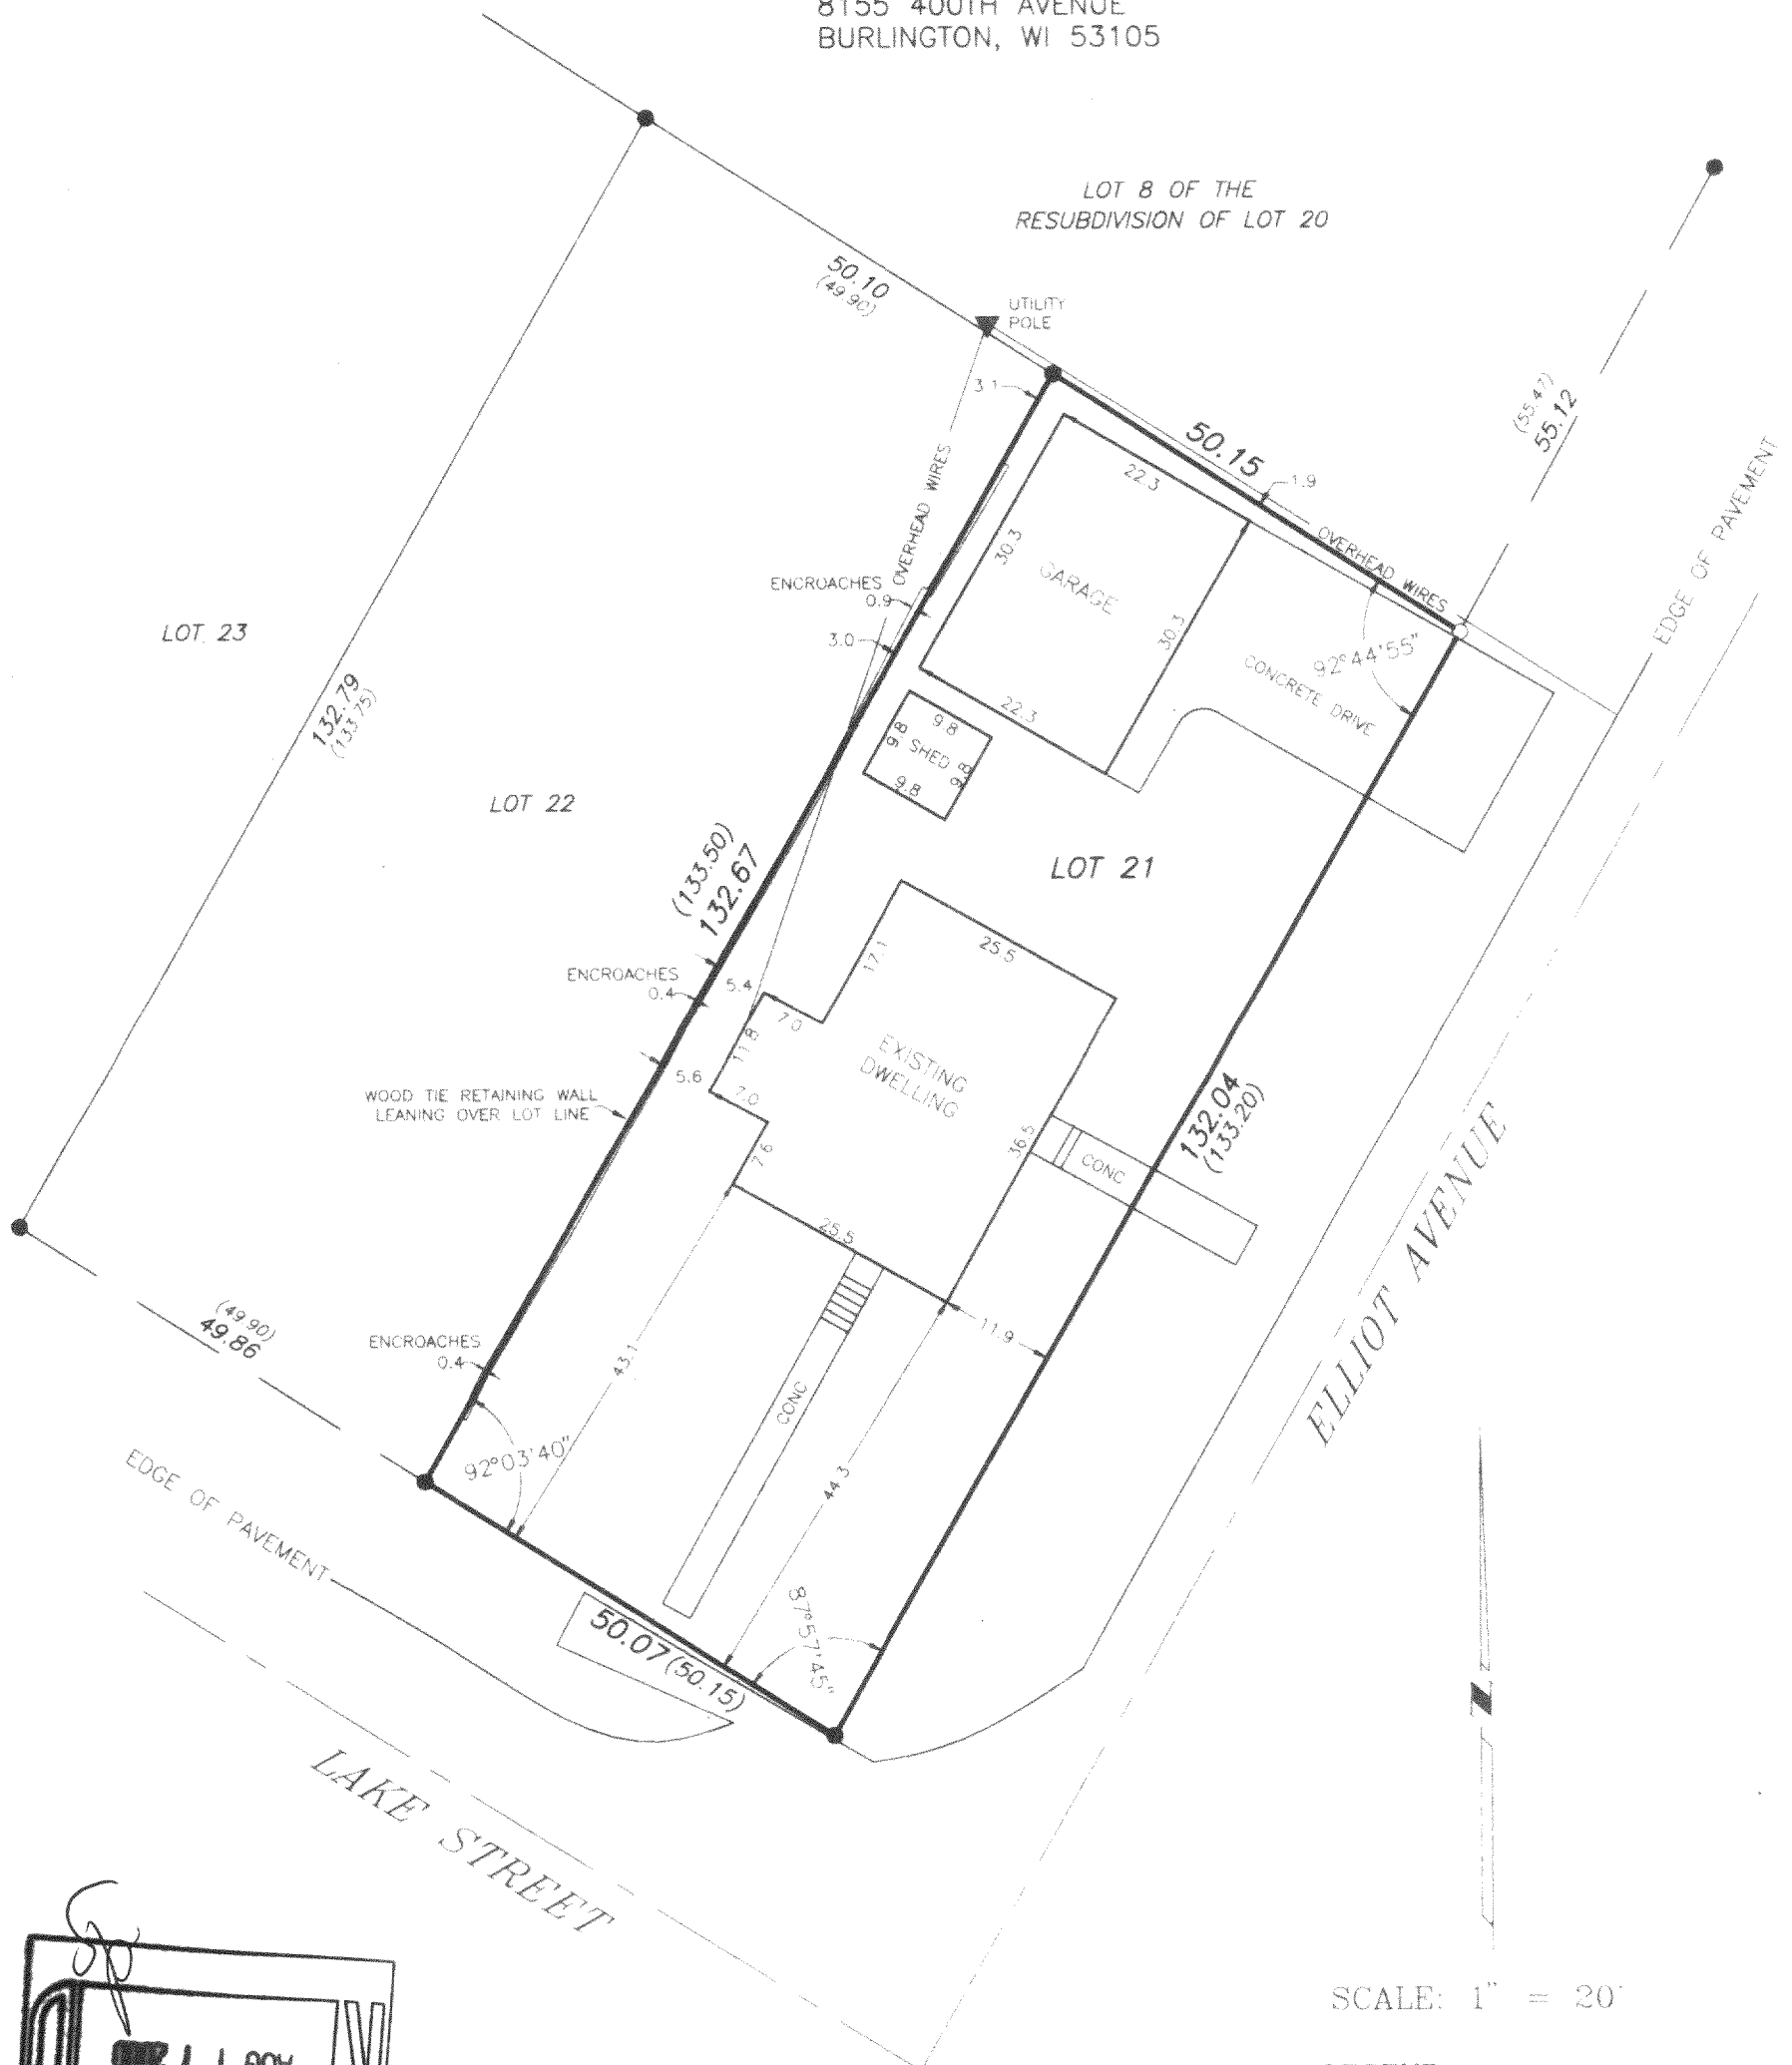

### LEGEND

- - FOUND IRON PIPE  
 ○ - SET IRON PIPE  
 ( ) - RECORDED AS

I HEREBY CERTIFY THAT I HAVE SURVEYED THE ABOVE DESCRIBED PROPERTY AND THE ABOVE MAP IS A TRUE REPRESENTATION THEREOF AND SHOWS THE SIZE AND LOCATION OF THE PROPERTY, THE LOCATION OF ALL VISIBLE STRUCTURES AND DIMENSIONS OF ALL PRINCIPAL BUILDINGS THEREON, BOUNDARY FENCES, APPARENT EASEMENTS, ROADWAY AND VISIBLE ENCROACHMENTS, IF ANY

THIS SURVEY IS MADE FOR THE PRESENT OWNERS OF THE PROPERTY, AND ALSO THOSE WHO PURCHASE, OR GUARANTEE THE TITLE THERETO  
WITHIN (1) YEAR FROM THE DATE HEREOF

DATED AT WATERFORD, WI THIS 20th DAY OF JULY 2000

RECEIVED

RECEIVED  
AUG 17 2000

118-1952

ME-21