

DEGEN, FOAT SURVEYING ASSOCIATES


100 SOUTH SECOND STREET
WATERFORD, WISCONSIN
(262)531-5404 (FAX)531-2022

004349
004349S1.DWG

PLAT OF SURVEY

LOTS 9843 THRU 9853, BLOCK 216 OF SECTION 7 OF PELL LAKE, A SUBDIVISION LOCATED IN THE
NORTHEAST 1/4 OF SECTION 21, TOWN 1 NORTH, RANGE 18 EAST, TOWNSHIP OF BLOOMFIELD, COUNTY
OF WALWORTH AND STATE OF WISCONSIN.

SURVEY PREPARED FOR: ALEDA PETERS
P.O. BOX 808
PELL LAKE, WI 53157

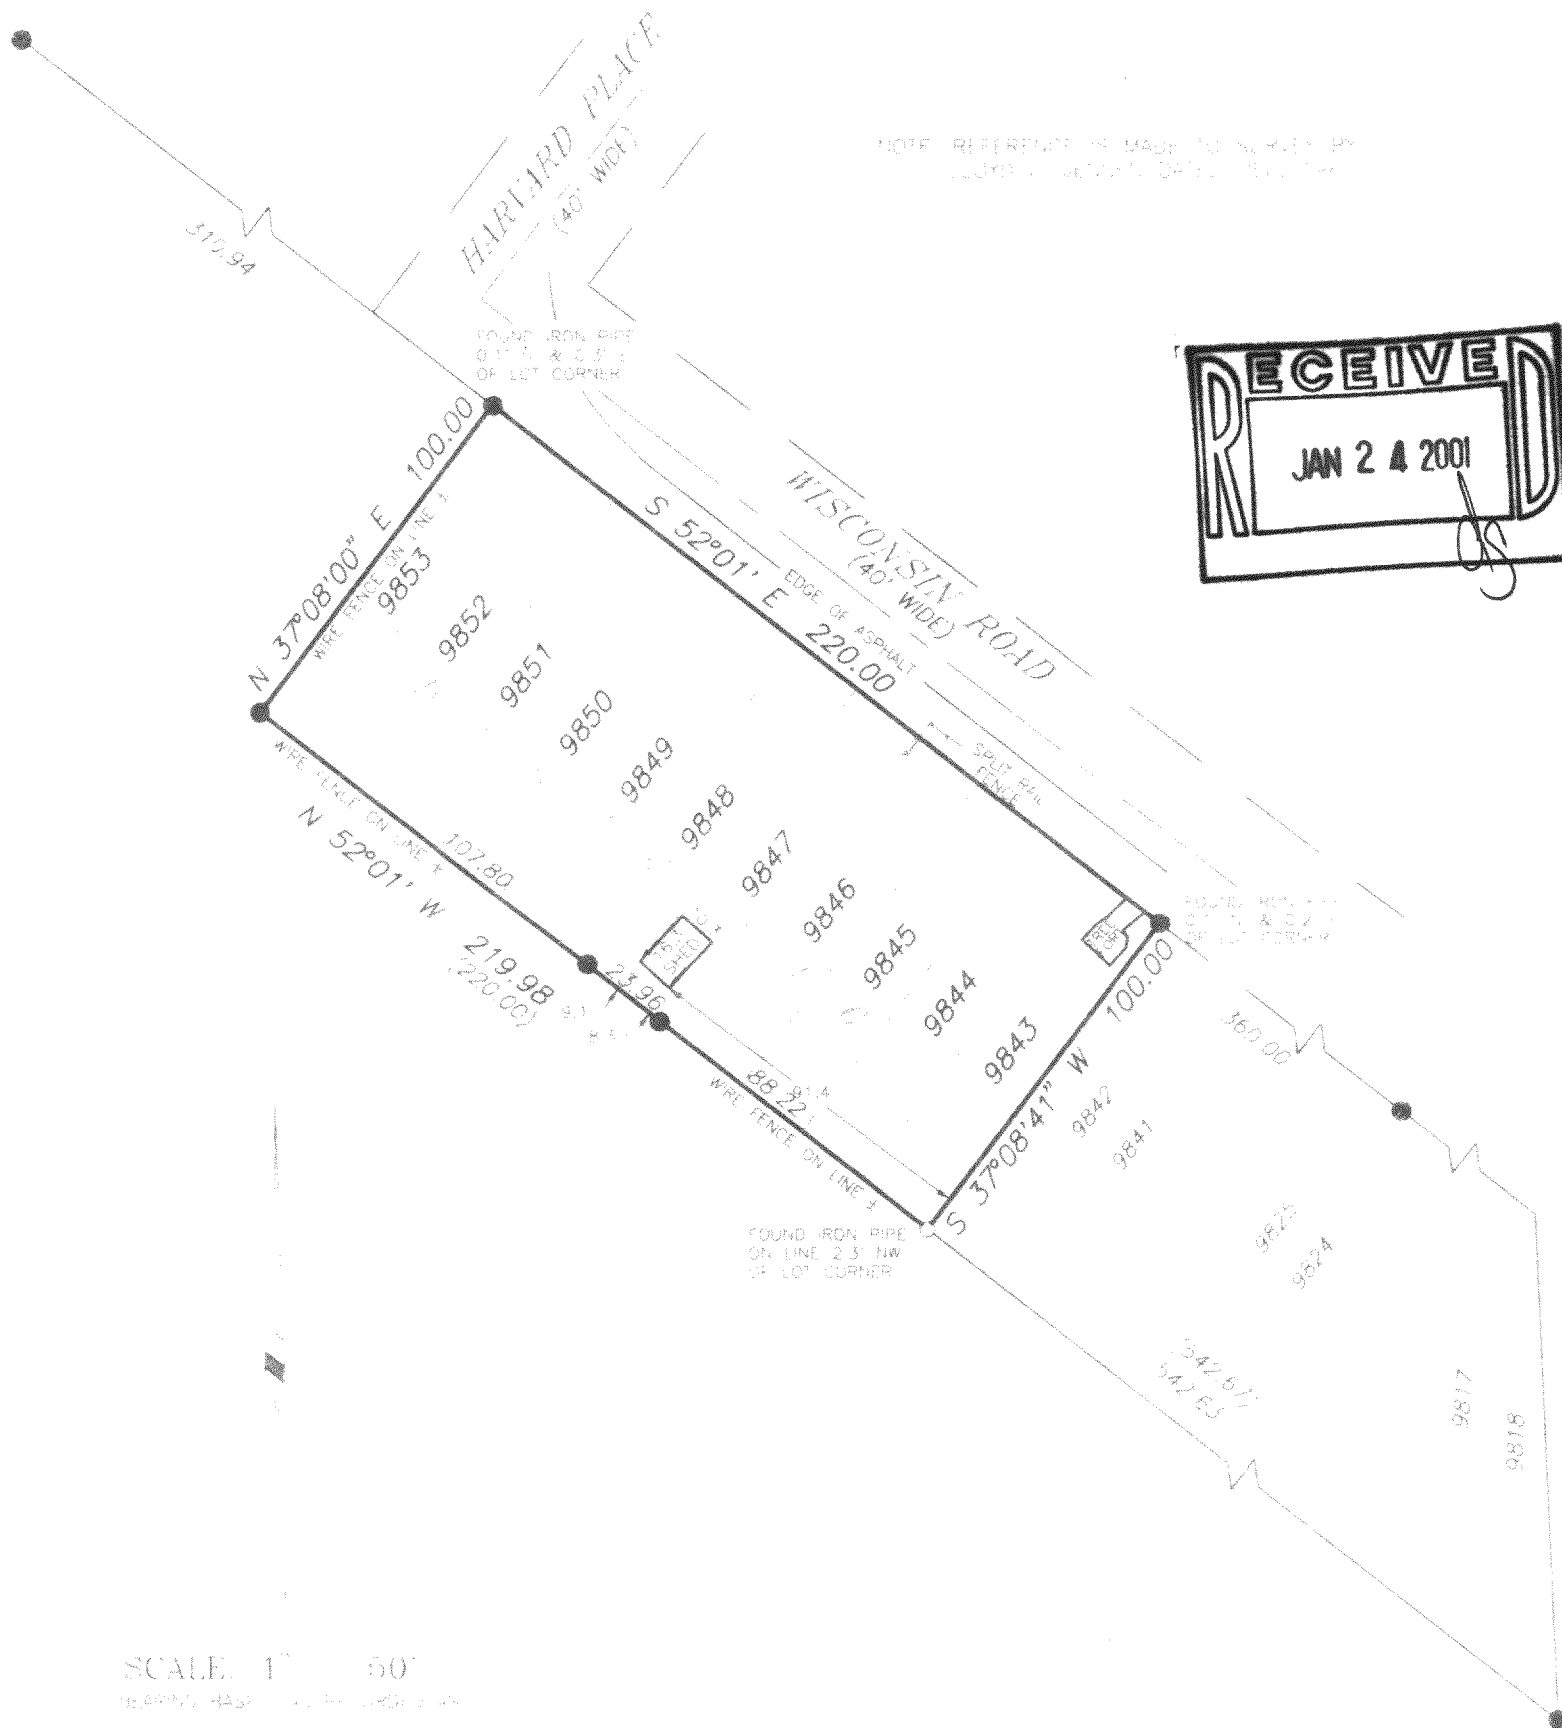

HEREBY CERTIFY THAT I HAVE SURVEYED THE ABOVE DESCRIBED PROPERTY AND THE ABOVE MAP IS A TRUE REPRESENTATION THEREOF
AND SHOWS THE SIZE AND LOCATION OF THE PROPERTY, THE LOCATION OF ALL VISIBLE STRUCTURES AND DIMENSIONS OF ALL PRINCIPAL
BUILDINGS THEREON, BOUNDARY FENCES, APPARENT EASEMENTS, ROADWAY AND VISIBLE ENCROACHMENTS, IF ANY.

THIS SURVEY IS MADE FOR THE PRESENT OWNERS OF THE PROPERTY AND ALSO THOSE WHO PURCHASE, OR GUARANTEE THE TITLE THERE TO
WITHIN (1) YEAR FROM THE DATE HEREOF

DATED AT WATERFORD, WI THIS 17th DAY OF NOVEMBER 2000

RECERTIFIED

Gregory D. Fout

MPL-1988

118-1998