

Aug 20 2001

MPL-832 118-2058

PETER S. GORDON R.L.S. 2101


[Signature]

DATED: APRIL 23, 2001

REVISED 8/20/2001 TO SHOW RESIDENCE AND GARAGE AS-BUILT.

I HEREBY CERTIFY THAT THE ABOVE DESCRIBED PROPERTY HAS BEEN SURVEYED UNDER MY DIRECTION AND THAT THE ABOVE MAP IS A TRUE REPRESENTATION THEREOF AND SHOWS THE SIZE AND LOCATION OF THE PROPERTY AND ITS EXTERIOR BOUNDARIES. THIS SURVEY IS MADE FOR THE USE OF THE PRESENT OWNERS OF THE PROPERTY, AND ALSO THOSE WHO PURCHASE, MORTGAGE, OR GUARANTEE THE TITLE THERETO WITHIN ONE YEAR FROM THE DATE HEREOF.



NOTE: COPIES OF THIS MAP TO WHICH THE FOLLOWING CERTIFICATE WILL APPLY SHOW SURVEYOR'S ORIGINAL SEAL AND SIGNATURE IN RED INK. COPIES BY ANY OTHER MEANS MAY HAVE ALTERATIONS WHICH DO NOT REPRESENT THE SURVEYOR'S WORK PRODUCT.

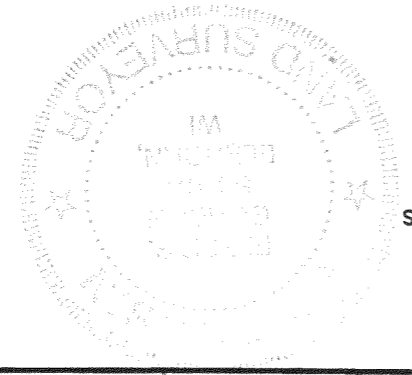


PROJECT 5784 SHEET 1 OF 1

WORK ORDERED BY:
DOUG ANDERSON
PO BOX 52
PELL LAKE, WI. 53157

LEGEND
○ = FOUND IRON PIPE STAKE
● = SET IRON REBAR STAKE
= = = = RECORDED AS (xxx)

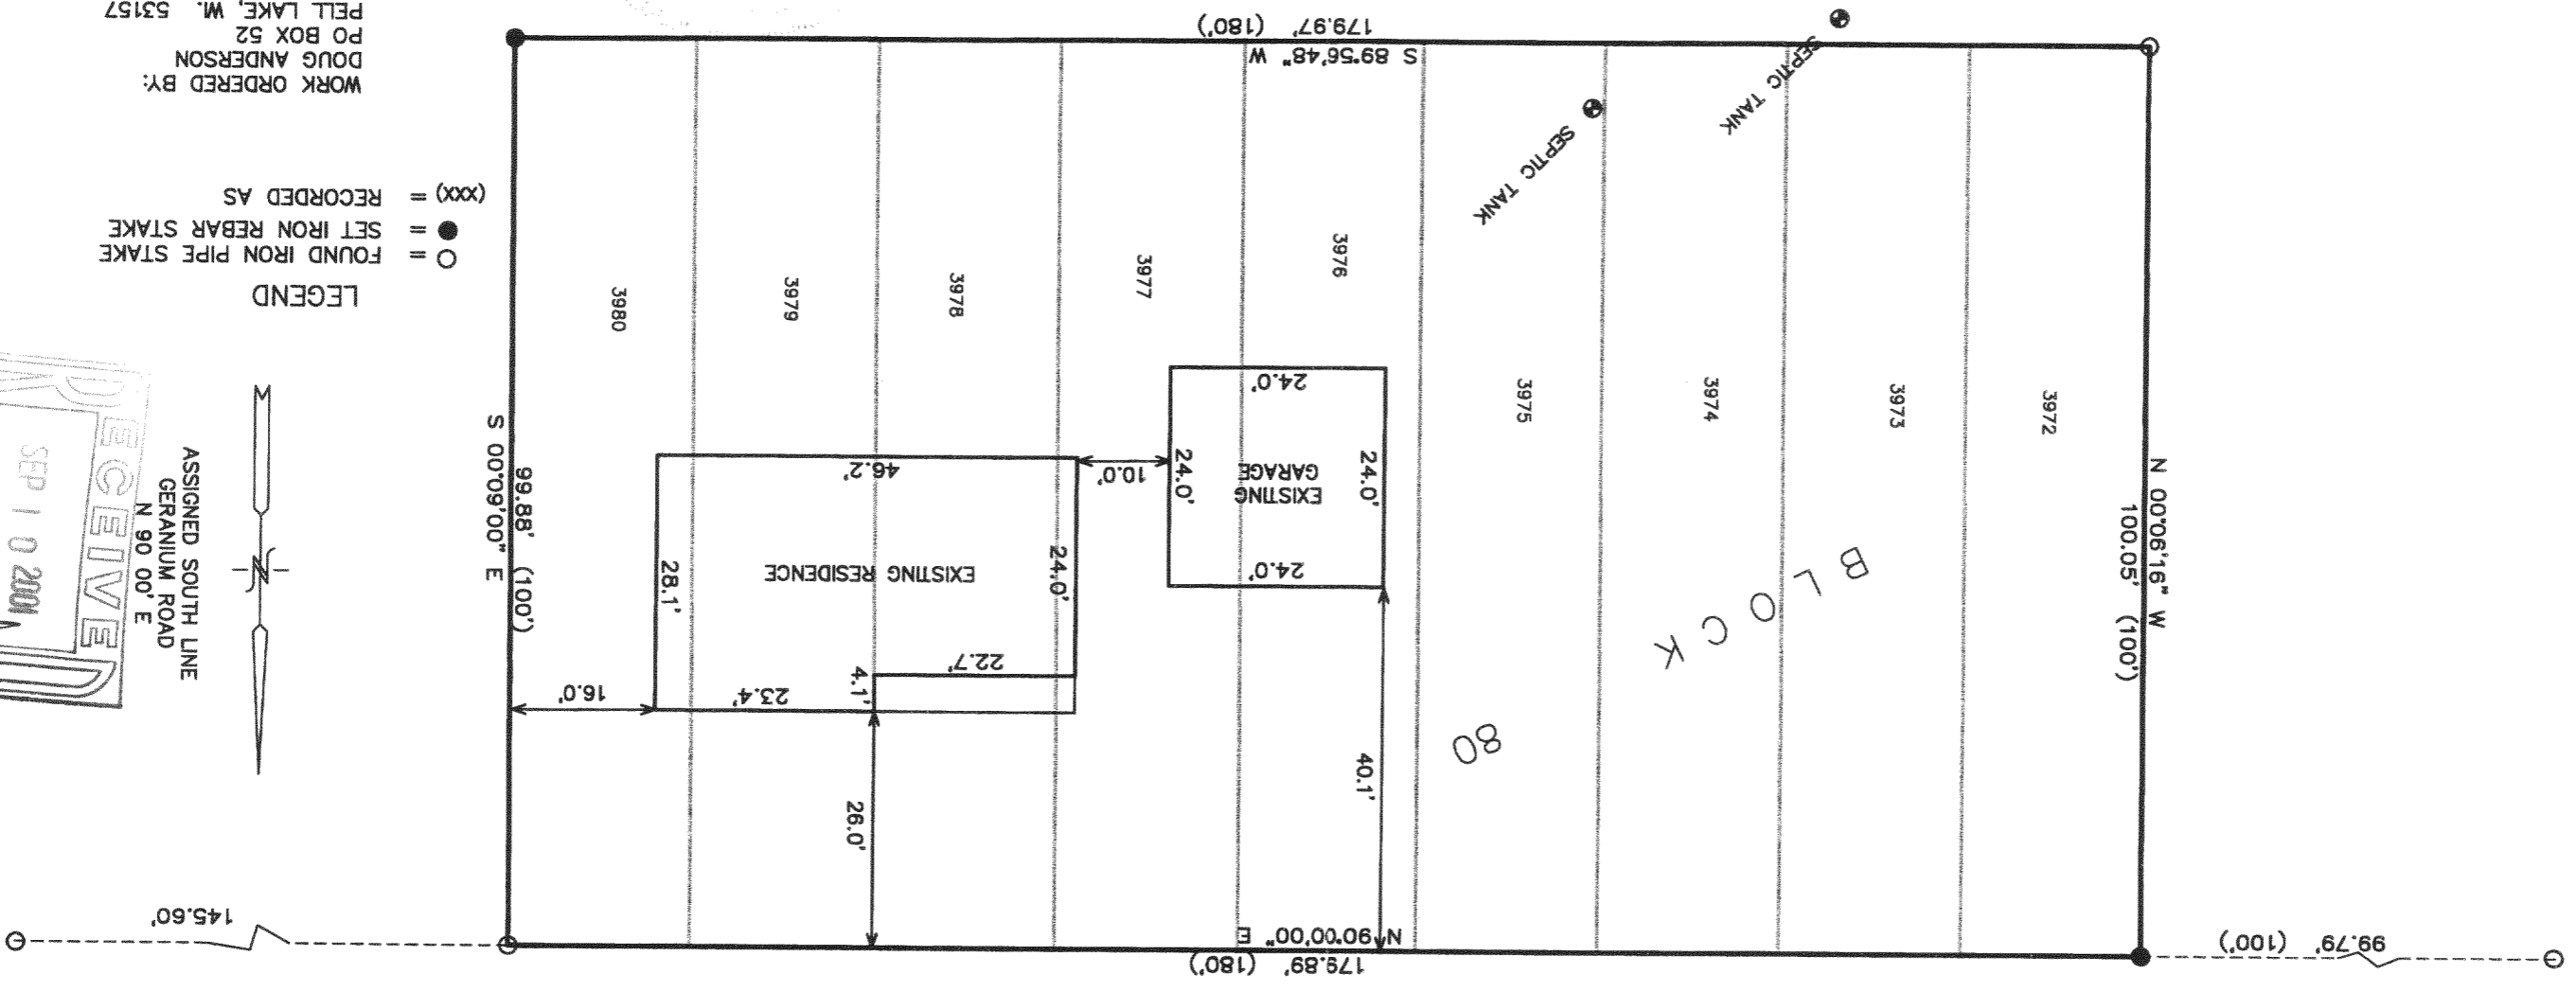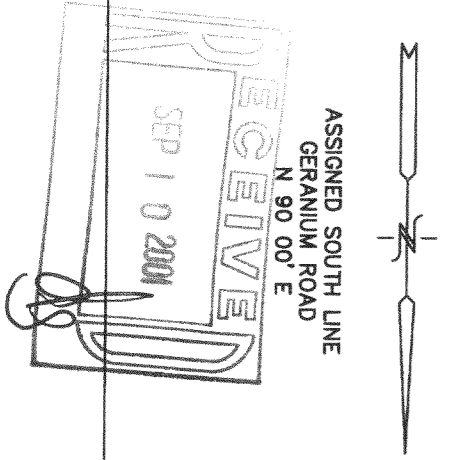

PLAT OF SURVEY
LOTS 3972 - 3980, BLOCK 80 OF SECTION 3
PELL LAKE SUBDIVISION
LOCATED IN TOWN 1 NORTH, RANGE 18 EAST
WALWORTH COUNTY, WISCONSIN

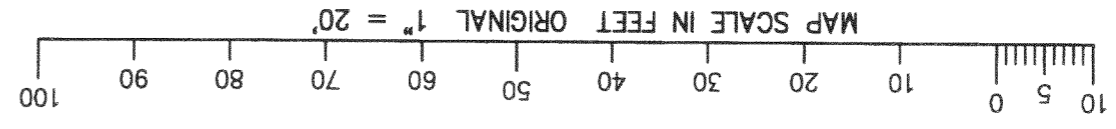

FARRIS, HANSEN & ASSOCIATES, INC.
ENGINEERING, ARCHITECTURE, SURVEYING
7 RIDGEWAY COURT - P.O. BOX 437, ELKHORN, WISCONSIN, 53121
PHONE: (262) 723-2098 FAX: (262) 723-5886

GERANIUM ROAD 40' WIDE ROW