
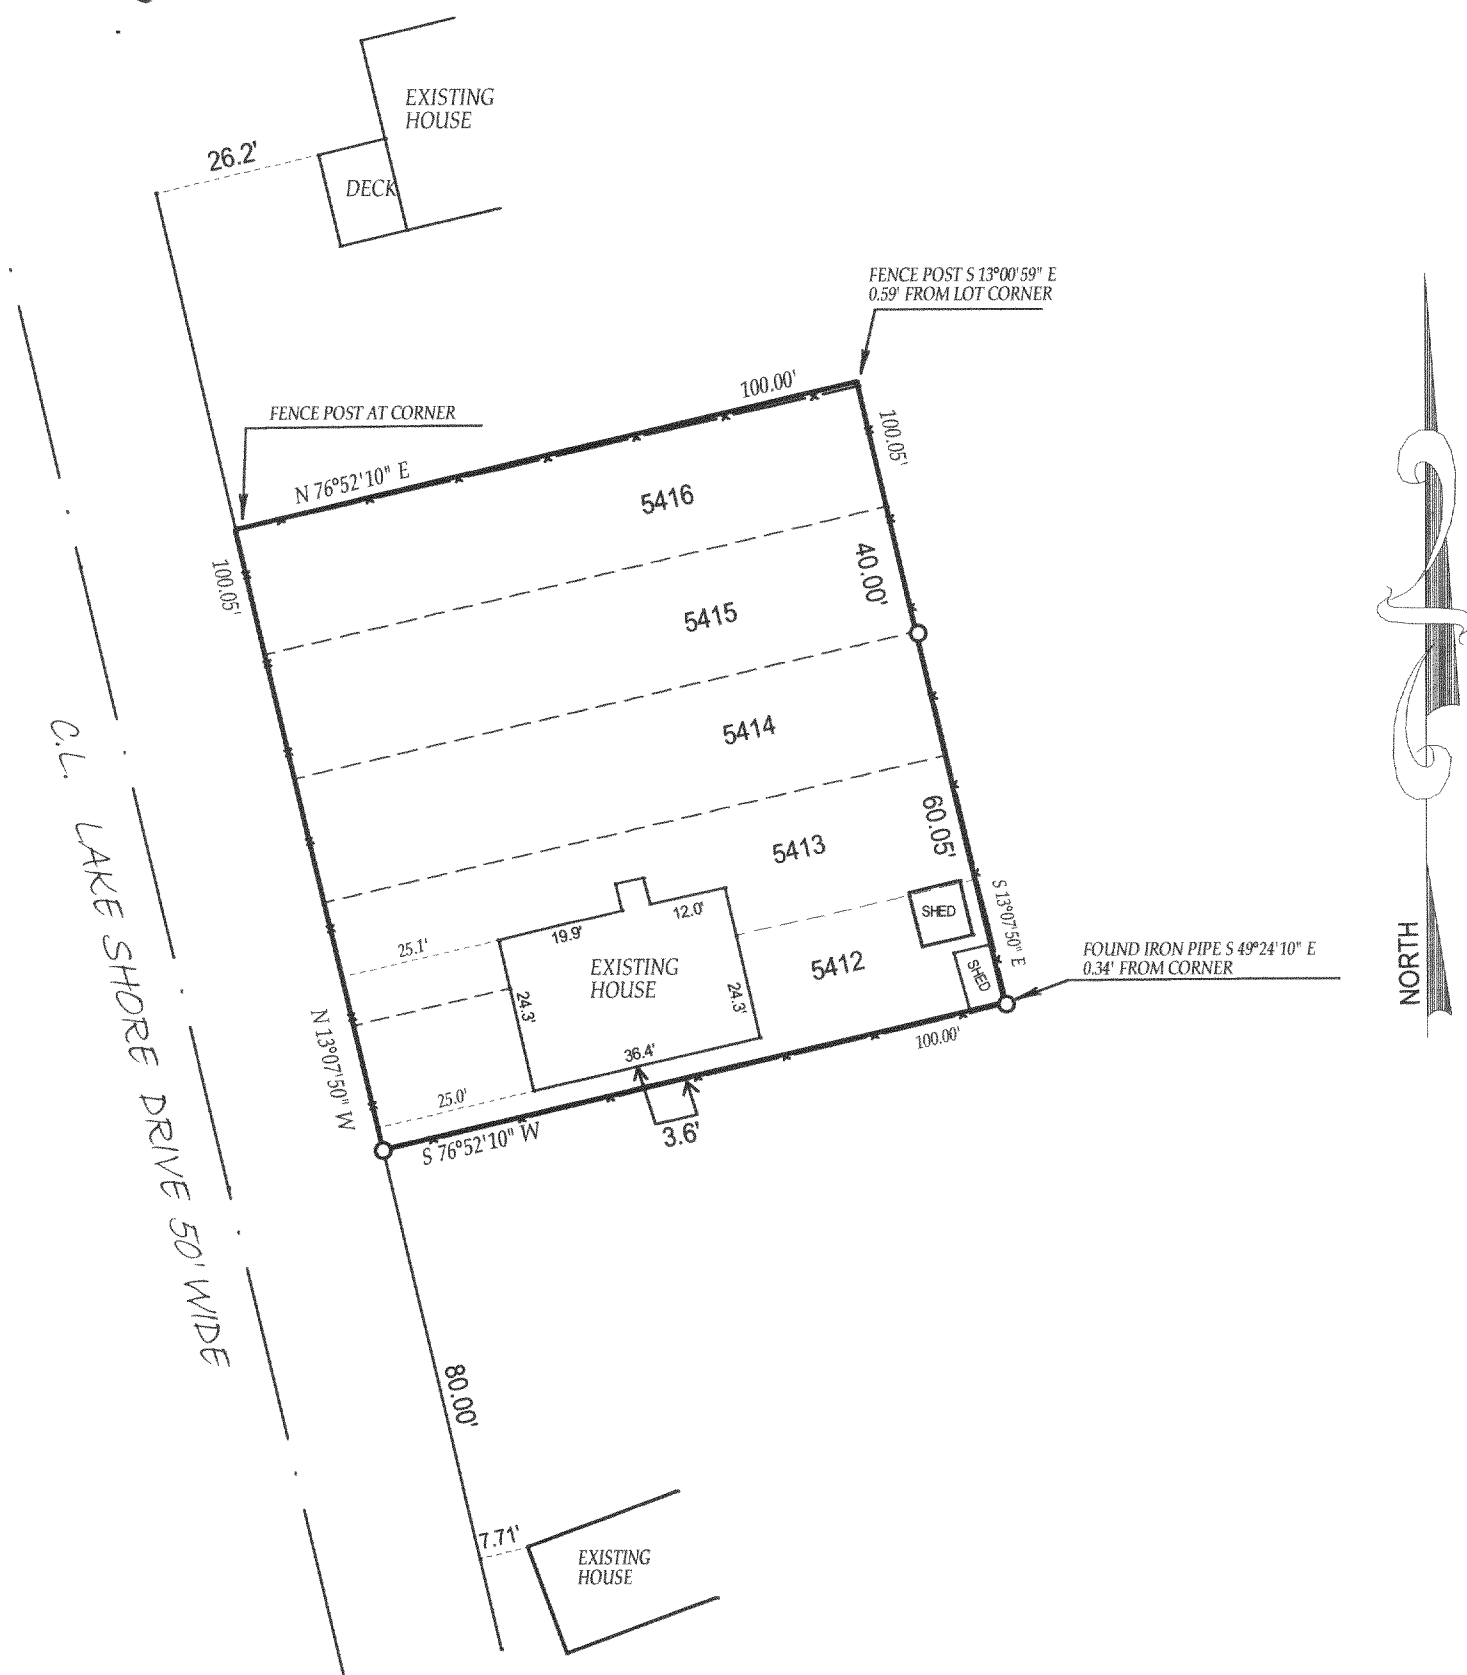


PLAT OF SURVEY

J.K. SURVEYING INC.
N3705 WILLOWBEND LANE
LAKE GENEVA, WI, 53147
262-248-3697

- OF -
LOTS 5412-5416 , BLOCK 107, PELL LAKE SUBDIVISION, T.1.N. ,
R.18.E. , WALWORTH COUNTY, WISCONSIN.

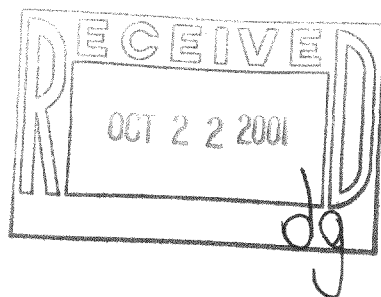


■ = set iron bar

TAX ID # MPL-01168

This survey is made for the present owners of the property, and those who purchase, mortgage, or guarantee the title thereto, within one year from the date hereof.

DATED THIS 15TH, DAY OF MAY 2001.

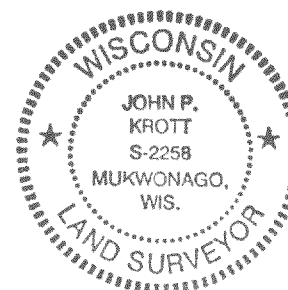

JOHN KROTT S - 2258
Wisconsin Registered Land Surveyor
(original if signed in red)

118-2067