
PREPARED FOR: HALLMARK REALTY P.O. BOX 1005 PELL LAKE WI 53157

## PLAT OF SURVEY

J.K. SURVEYING INC. N3705 WILLOWBEND LANE LAKE GENEVA, WI, 53147 262-248-3697

THE EAST 60 FEET OF LOTS 74 THRU 78 BLK 2 PELL LAKE HIGHLANDS SUBDIVISION AND LOTS 9484 THRU 9488 PELL LAKE SUBDIVISION ALL LOCATED IN T.1.N. R.18.E, WALWORTH COUNTY, WISCOSIN.

HONEYSUCKLE ROAD (40' WIDE)

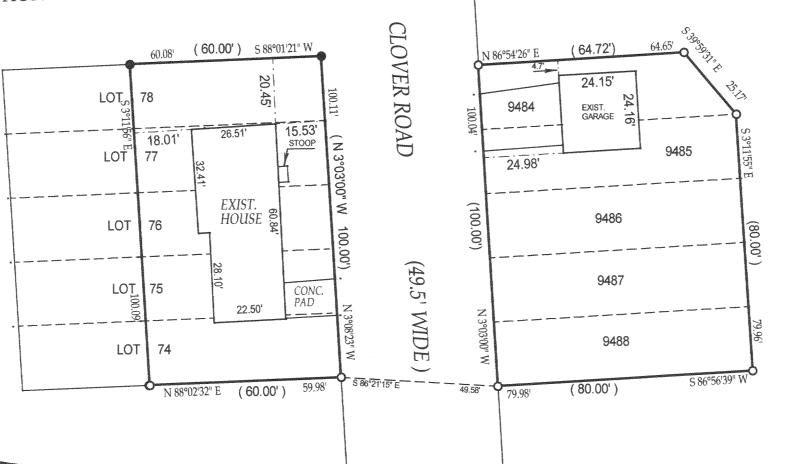

( )= recorded as

= found iron bar

= found iron pipe

= set iron pipe

= set iron bar

SCALE 1" = 30'

JOB # 01-459

TAX ID # MPL-1923 & MPLH-17

COMPARE LEGAL DESCRIPTION ABOVE AND DRAWING WITH DEED. FOR BUILDING RESTRICTIONS AND EASEMENTS NOT SHOWN, REFER TO DEED, ABSTRACT SOURCES AND LOCAL MUNICIPAL CODES. NOTIFY THE SURVEYOR IMMEDIATELY OF ANY DISCREPANCY.

"I hereby certify that I have surveyed the above described property and that the above map is a true representation thereof and shows the size and location of all visible structures, apparent easements and encroachments if any."

This survey is made for the present owners of the property, and those who purchase, mortgage, or guarantee the title thereto, within one year from the date hereof.

DATED THIS

12

TH, DAY OF OCTOBER 20 01

MPL-1923

MPLH-17

118-9210



MUKWONAGO

JOHN KROTT S - 2258

(original if signed in red)

Wisconsin Registered Land Surveyor