


Lot 25 of WILLIAM ELLIOTT'S POWERS LAKE SUBDIVISION, EXCEPTING THEREFROM the southerly 175 feet thereof and the easterly 50 feet hereof, all in the Town of Bloomfield, Walworth County, Wisconsin.

ALSO,

The northerly 25 feet of the south 175 feet of William Elliott's Powers Lake Subdivision, said parcel being subject however to the right of foot passenger's to and from said public highway and Power's lake reserved to the owners of real estate embraced within the Zuhde Subdivision, according to the plat thereof recorded in Volume 10 of Plats, page 36, Walworth County, Wisconsin.

LEGAL DESCRIPTION PER DOCUMENT NUMBER 189915

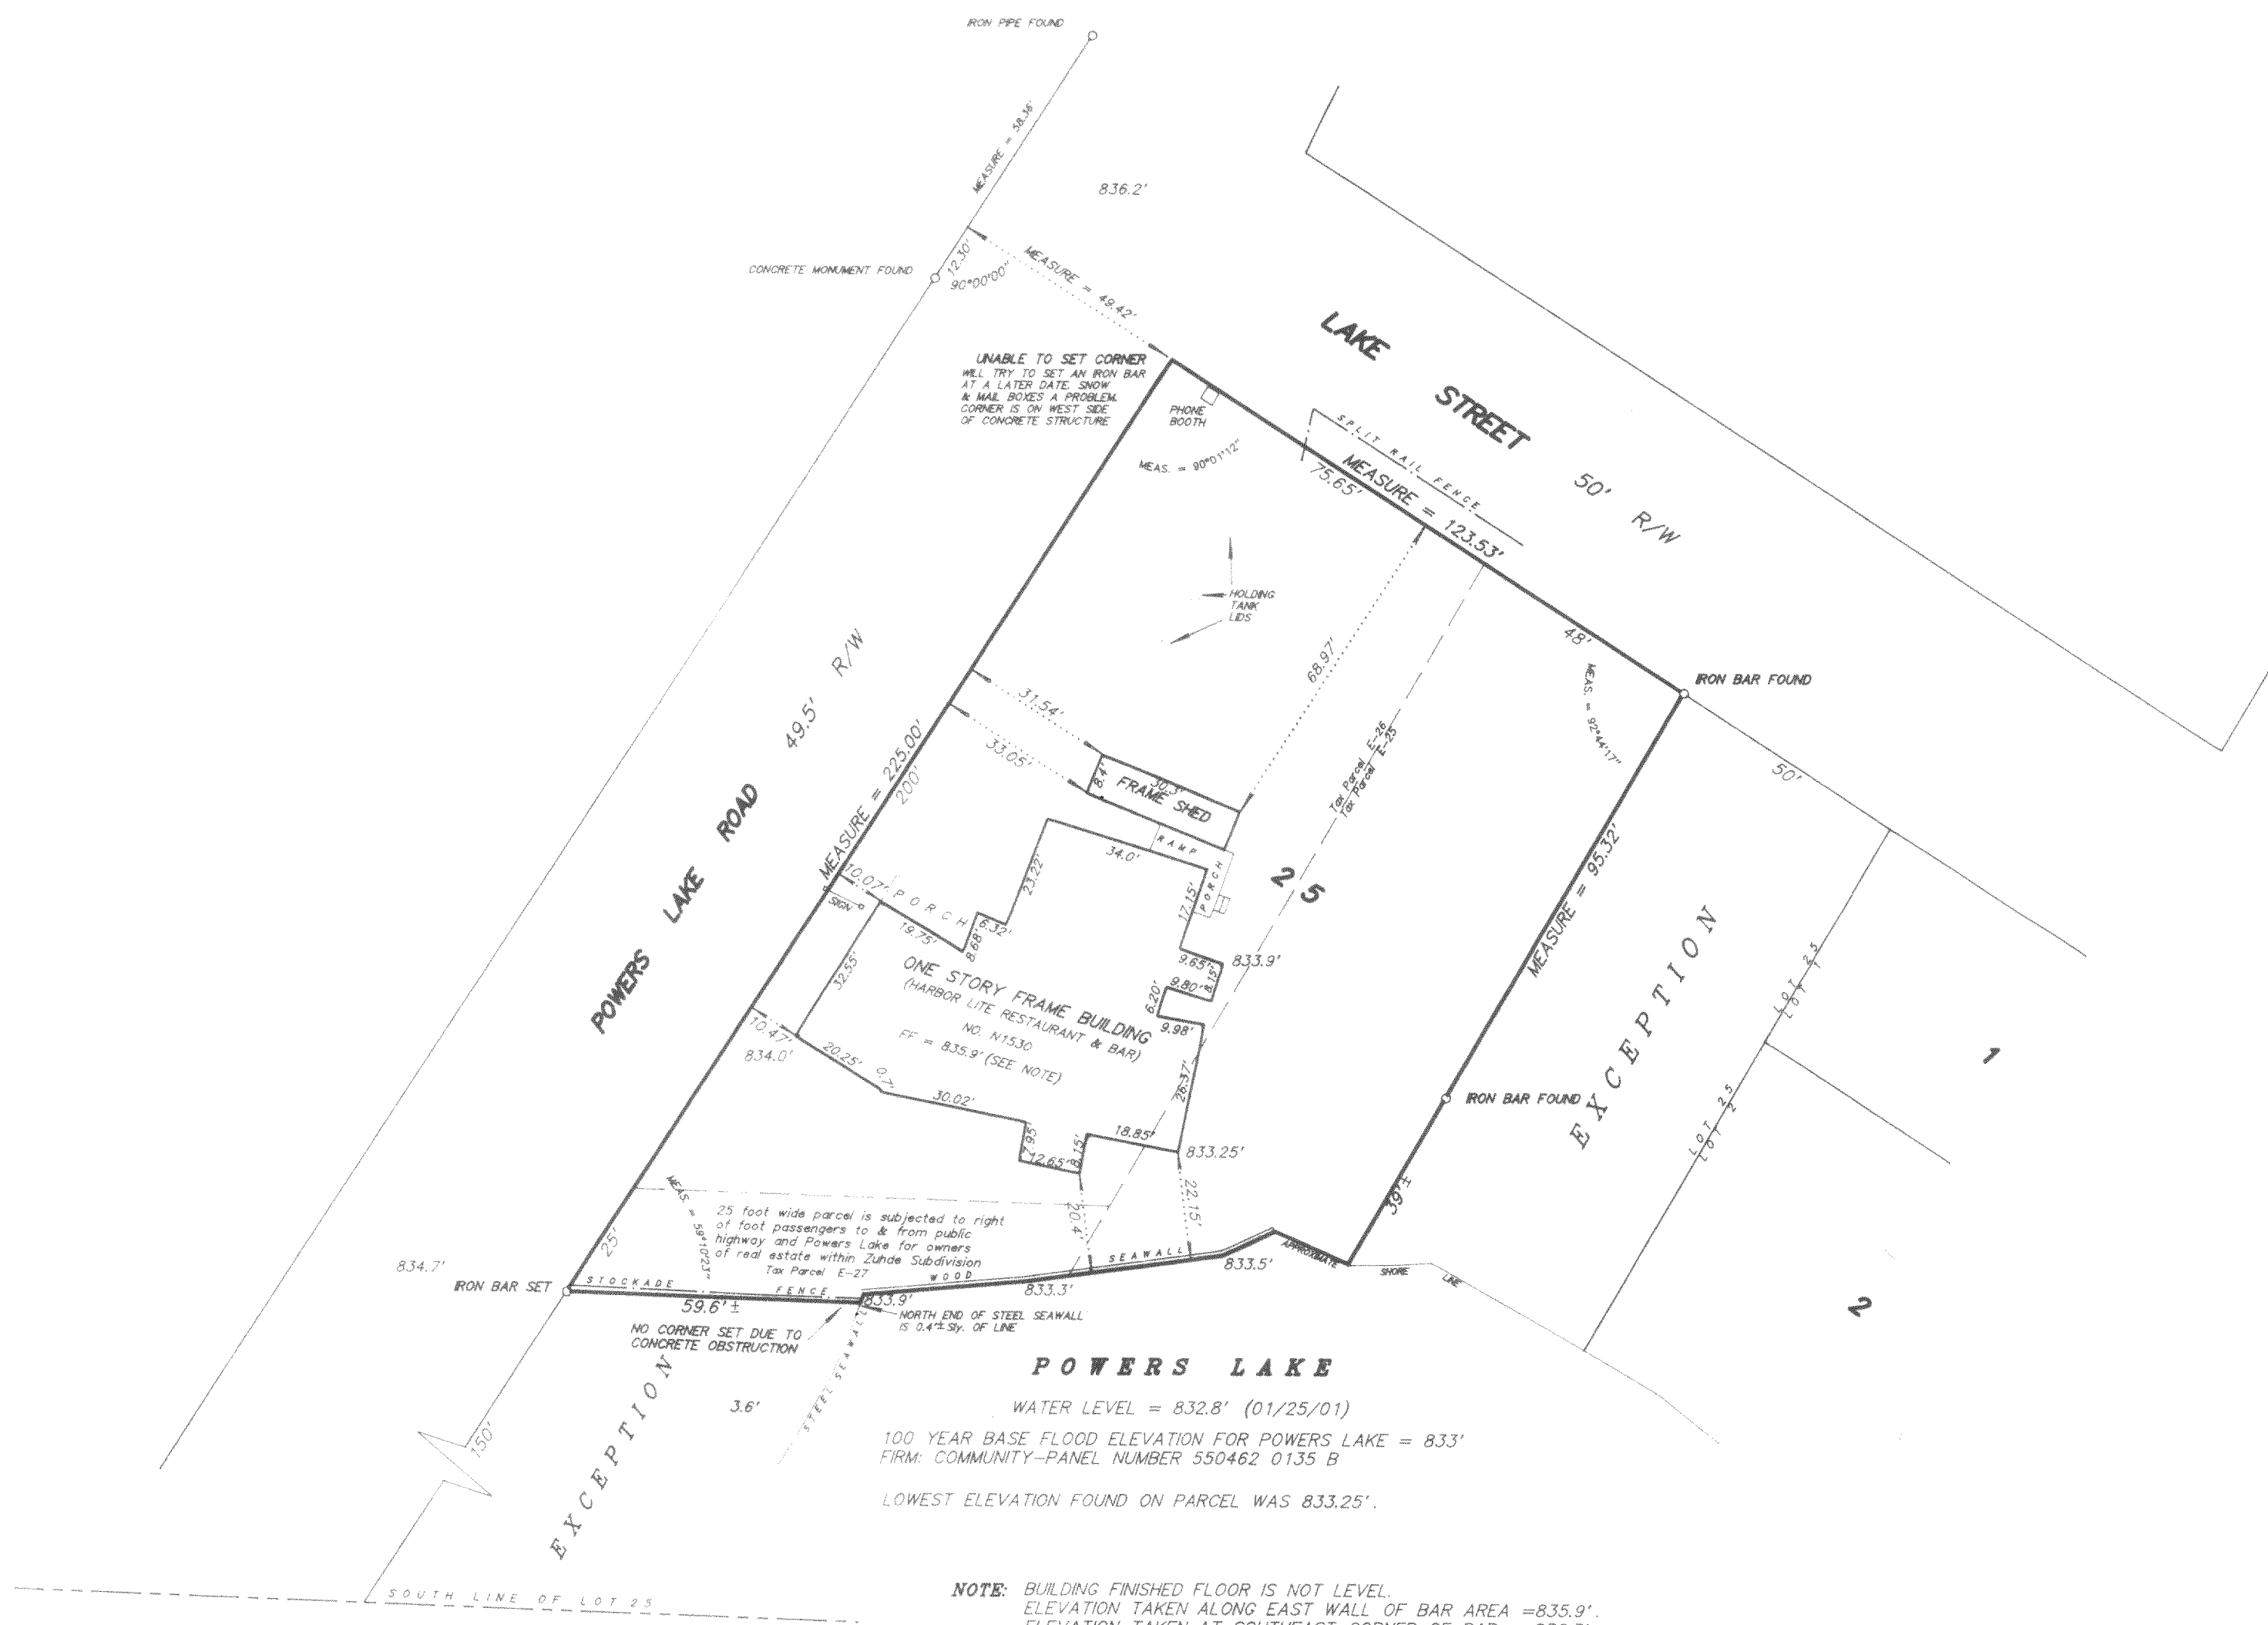

NOTE: BUILDING FINISHED FLOOR IS NOT LEVEL.
ELEVATION TAKEN ALONG EAST WALL OF BAR AREA = 835.9'.
ELEVATION TAKEN AT SOUTHEAST CORNER OF BAR = 836.3'

Ground detail, ie. walks, patios, parking area, not shown due to snow and ice. Shore line of Powers Lake was also obscured due to snow and ice.

BENCH MARK: Chiseled square north side concrete wall on Powers Lake Road bridge over East Branch Nippersink Creek.
ELEVATION = 833.70' per FIRM map (RM50)



SCALE 1 inch = 30 feet
ORDERED BY E. Klein
JOB NO. 0 1 0 0 7

I hereby certify that I have surveyed the above described property and the above plat is a true representation thereof and shows the size and location of the property, its exterior boundaries, the location and dimensions of all visible structures thereon, boundary fences, apparent easements and roadways and visible encroachments, if any.

This survey is made for the exclusive use of the present owners of the property, and also those who purchase, mortgage, or guarantee the title thereto within one year from the date hereof.

Dated at Bassett, Wisconsin this _____ day of _____ 2001.

Mark A. Bolender
Wisconsin Registered Land Surveyor S - 1784

ME-28
ME-26

118-2073