


MPLH-342

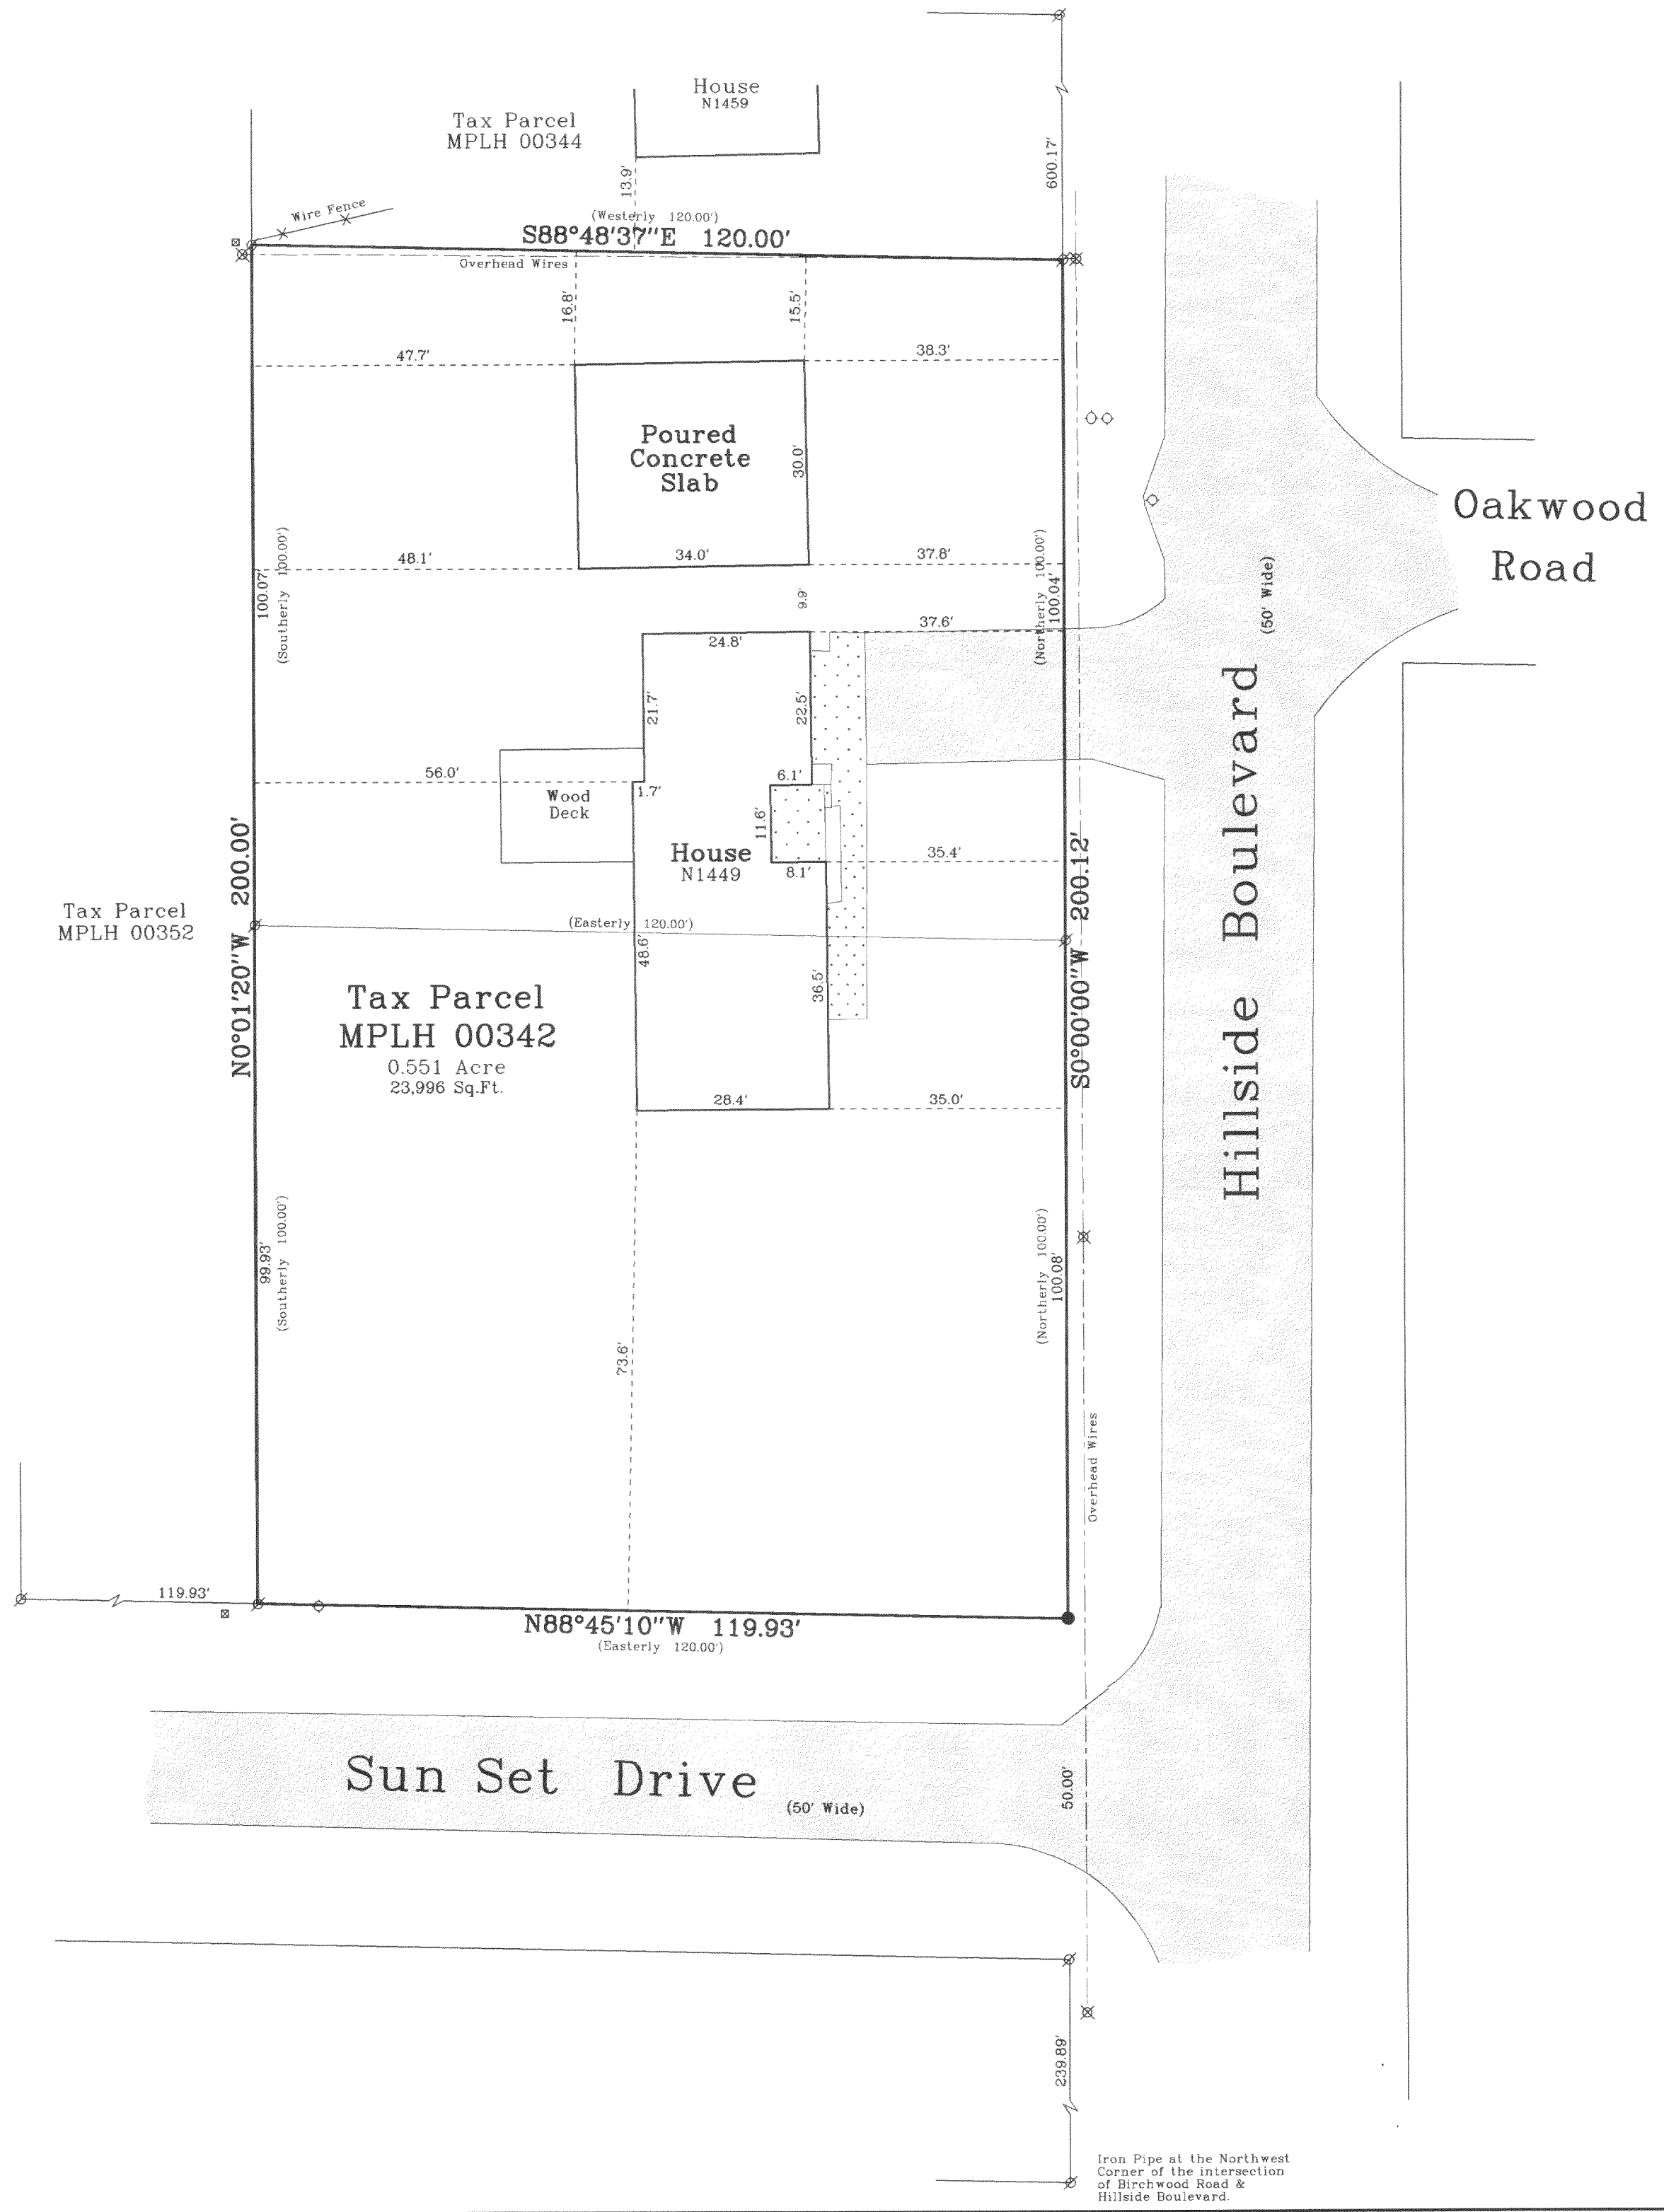

Plat of Survey



of

A parcel of land described in a Warranty Deed recorded in Vol. 655 on Page 3032 as Document No. 384727 as shown below:


A parcel of land located in the parcel of land designated as "Golf Course" on the plat of Pell Lake Highlands, as recorded in Volume 8, page 27 of Plats at the Register of Deeds Office in Elkhorn, Wisconsin and described as follows, to-wit: Commencing at the Northwest corner of the intersection of Birchwood Road and Hillside Boulevard in said Pell Lake Highlands, thence Northerly along the Westerly line of said Hillside Boulevard 389.89 feet to the place of beginning; thence continue Northerly along the Westerly line of said Hillside Boulevard 100.00 feet to a point; thence Westerly parallel to the North line of said Pell Lake Highlands, 120.00 feet to a point; thence Southerly parallel to the West line of said Hillside Boulevard 100.00 feet to a point; thence Easterly 120.00 feet to the place of beginning. Said land is located in the SE 1/4 of Section 16, Town 1 North, Range 18 East, Walworth County, Wisconsin.

A parcel of land located in the parcel of land designated as "Golf Course" on the Plat of Pell Lake Highlands, as recorded in Volume 8, page 27 of Plats at the Register of Deeds Office in Elkhorn, Wisconsin and described as follows, to-wit: Commencing at the Northwest corner of the intersection of Birchwood Road and Hillside Boulevard in said Pell Lake Highlands, thence Northerly along the Westerly line of said Hillside Boulevard 289.89 feet to the place of beginning; thence continue Northerly along the Westerly line of said Hillside Boulevard 100.00 feet to a point; thence Westerly parallel to the North line of said Pell Lake Highlands, 120.00 feet to a point; thence Southerly parallel to the West line of said Hillside Boulevard 100.00 feet to a point; thence Easterly 120.00 feet to the place of beginning. Said land is located in the SE 1/4 of Section 16, Town 1 North, Range 18 East, Walworth County, Wisconsin.

Surveyed for: **Chris & Kay Weinfurter**
N1449 Hillside Boulevard
Lake Geneva, Wisconsin. 53147

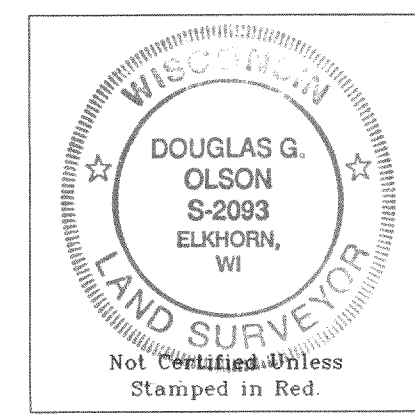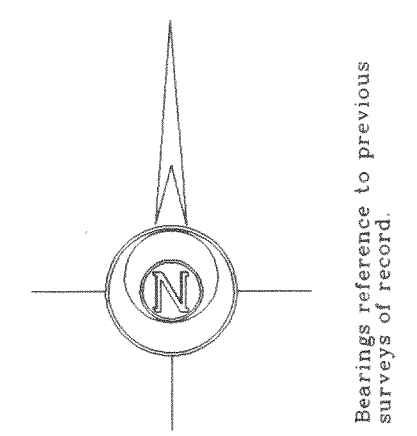

- Notes: 1) This survey plat is not certified unless signed and sealed in red ink.
- 2) This survey is subject to Wisconsin lien laws. This Plat of Survey is the notice of intent to file lien. Lien waiver required.

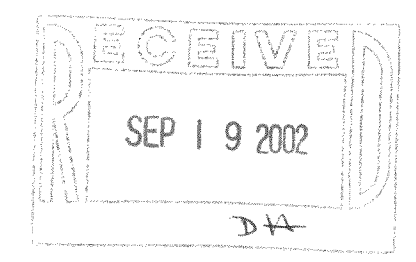


Copyright © 2002 by Jensen & Olson Land Surveying, LLC.

All rights reserved. No part of this survey plat may be reproduced or transmitted in any form by any means - graphic, electronic, or mechanical, including photocopying, tracing, or information storage and retrieval systems - without permission in writing from Douglas G. Olson, Jensen & Olson Land Surveying, LLC.

I, Douglas G. Olson, Wisconsin Registered Land Surveyor, do hereby certify that this survey was performed by me or under my direction in full compliance with the owner's/agent's instructions and Chapter A-E 7 of the Wisconsin Administrative Code "Minimum Standards for Property Surveys", and that this map is an accurate representation thereof to the best of my knowledge and belief.

Douglas G. Olson
Wisconsin Registered Land Surveyor - 2093

Survey Date: March 15, 2002.
Revisions: No. 1 - Poured Slab

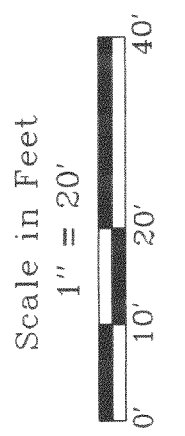

Jensen & Olson Land Surveying, LLC
45 South Wisconsin Street
P.O. Box 322
Elkhorn, Wisconsin, 53121
Telephone (262) 723-3434
Facsimile (262) 723-8044

- Legend**
- Found Iron Pipe
 - Found Iron Rod, 3/4" dia.
 - Recorded Information
 - Utility Pole
 - Utility Pedestal
 - Hydrant
 - Water Valve
 - Asphalt Surface
 - Concrete

Sheet 1 of 1 Sheets
Job Reference Number
2002.116
2002.116

118-2160