




PREPARED FOR:

CHRISTOPHER M. KENDZIOR
N1203 TOMBEAU RD.
GENOA CITY, WI. 53128

PLAT OF

PART OF LOTS 52-55, SHINNER'S 8TH ADDITION TO NIPPERSINK PARK,
LOCATED IN SECTION 24, T1N, R18E, WALWORTH COUNTY, WI.

J.K. SURVEYING INC.
N3705 WILLOWBEND LANE
LAKE GENEVA, WI, 53147
262-248-3697

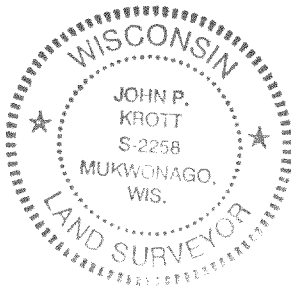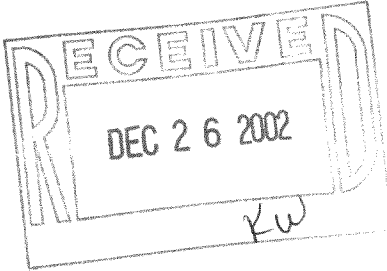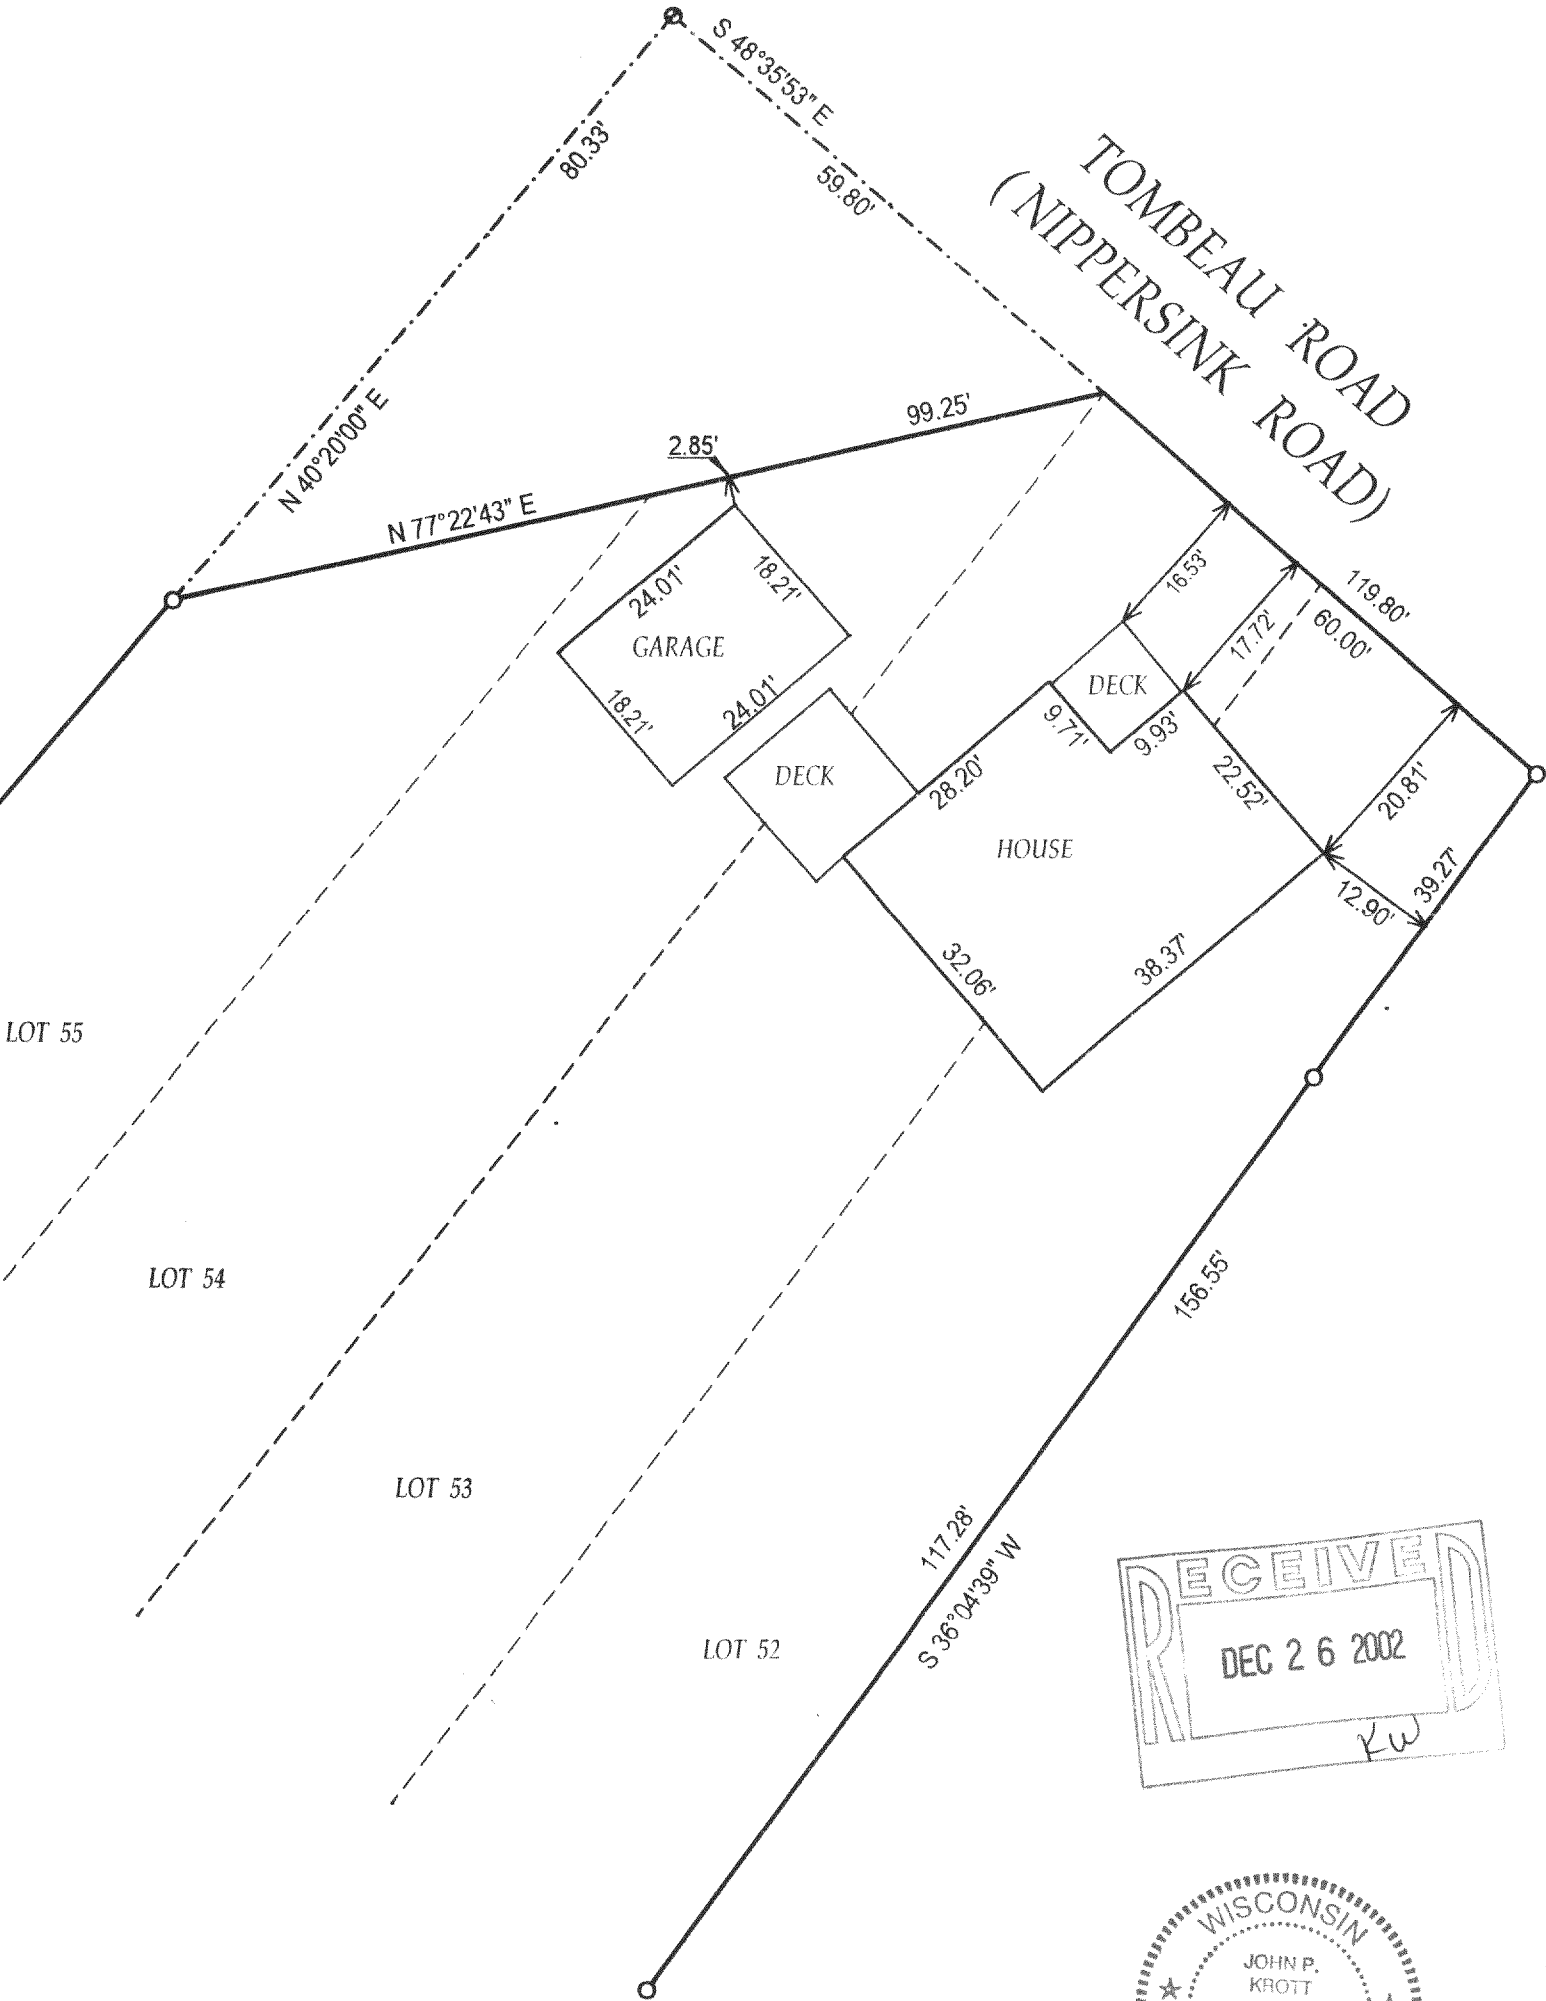

- ⊕ = found concrete monument
- = found iron bar
- = found iron pipe
- = set iron pipe

SCALE 1" = 20'

JOB # 02-655

TAX ID # MNPS 800091

COMPARE LEGAL DESCRIPTION ABOVE AND DRAWING WITH DEED. FOR BUILDING RESTRICTIONS AND EASEMENTS NOT SHOWN, REFER TO DEED, ABSTRACT SOURCES AND LOCAL MUNICIPAL CODES. NOTIFY THE SURVEYOR IMMEDIATELY OF ANY DISCREPANCY.

"I hereby certify that the above described property was surveyed under my supervision and that the above map is a true representation thereof and shows the size and location of all visible structures, apparent easements and encroachments if any."

This survey is made for the present owners of the property, and those who purchase, mortgage, or guarantee the title thereto, within one year from the date hereof.

DATED THIS 20 TH, DAY OF DECEMBER 20 02 .

John P. Krott
JOHN KROTT S - 2258
Wisconsin Registered Land Surveyor
(original if signed in red)

1 MNPS 8-91

118-295