
PREPARED FOR: LARRY HODGES REALTY CENTURY 21 C/O VAL SCHNEIDER P.O. BOX 939 TWIN LAKES, WI 53181


## PLAT OF SURVEY

- OF -

J.K. SURVEYING INC. N3705 WILLOWBEND LANE LAKE GENEVA, WI, 53147 262-248-3697

LOT 12 WM ELLIOTTS POWERS LAKE SUBDIVISION BEING A SUBDIVISION OF A PART OF THE NORTHEAST FRACTIONAL 1/4 OF SECTION 13 TOWN 1 NORTH RANGE 18 EAST IN THE TOWN OF BLOOMFIELD WALWORTH COUNTY WISCONSIN

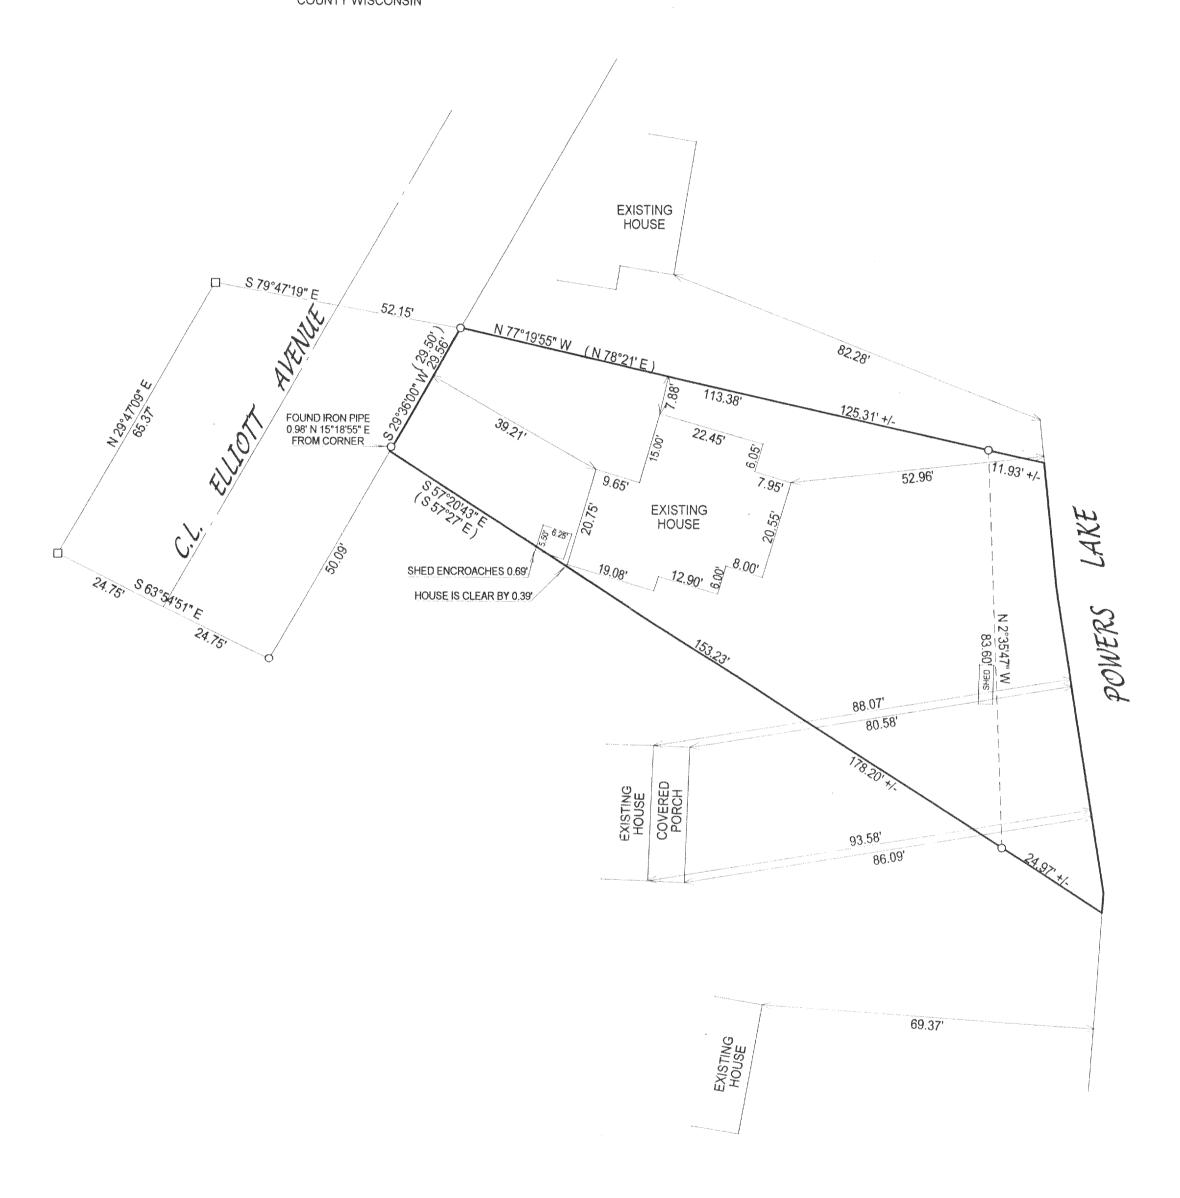

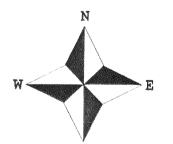

( )= recorded as

= found iron bar

= found iron pipe

= set iron pipe

= set iron bar SCALE 1" = 20'

JOB # 02-627

TAX ID # ME00012

COMPARE LEGAL DESCRIPTION ABOVE AND DRAWING WITH DEED. FOR BUILDING RESTRICTIONS AND EASEMENTS NOT SHOWN, REFER TO DEED, ABSTRACT SOURCES AND LOCAL MUNICIPAL CODES. NOTIFY THE SURVEYOR IMMEDIATELY OF ANY DISCREPANCY.

"I hereby certify that I have surveyed the above described property and that the above map is a true representation thereof and shows the size and location of all visible structures, apparent easements and encroachments

This survey is made for the present owners of the property, and those who purchase, mortgage, or guarentee the title thereto, within one year from the date hereof.





JEFFERY L.

KIMPS 2436

LAKE GENEVA, WIS.

DATED THIS THE 10th DAY OF DECEMBER 2002.