
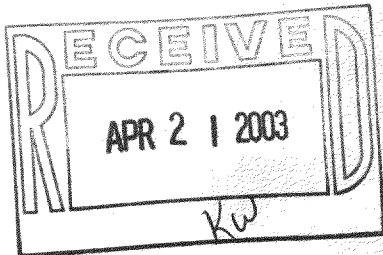


AMBIT LAND SURVEYING
P. O. BOX 42
Bassett, WI. 53101

PLAT OF SURVEY OF

PHONE 262-537-4874
FAX 262-537-4221

Lots 9055 thru 9066, Block 156 of PELL LAKE SUBDIVISION, being part of Section 22,
Township 1 North, Range 18 East of the 4th Principal Meridian, Bloomfield Township,
Walworth County, Wisconsin.

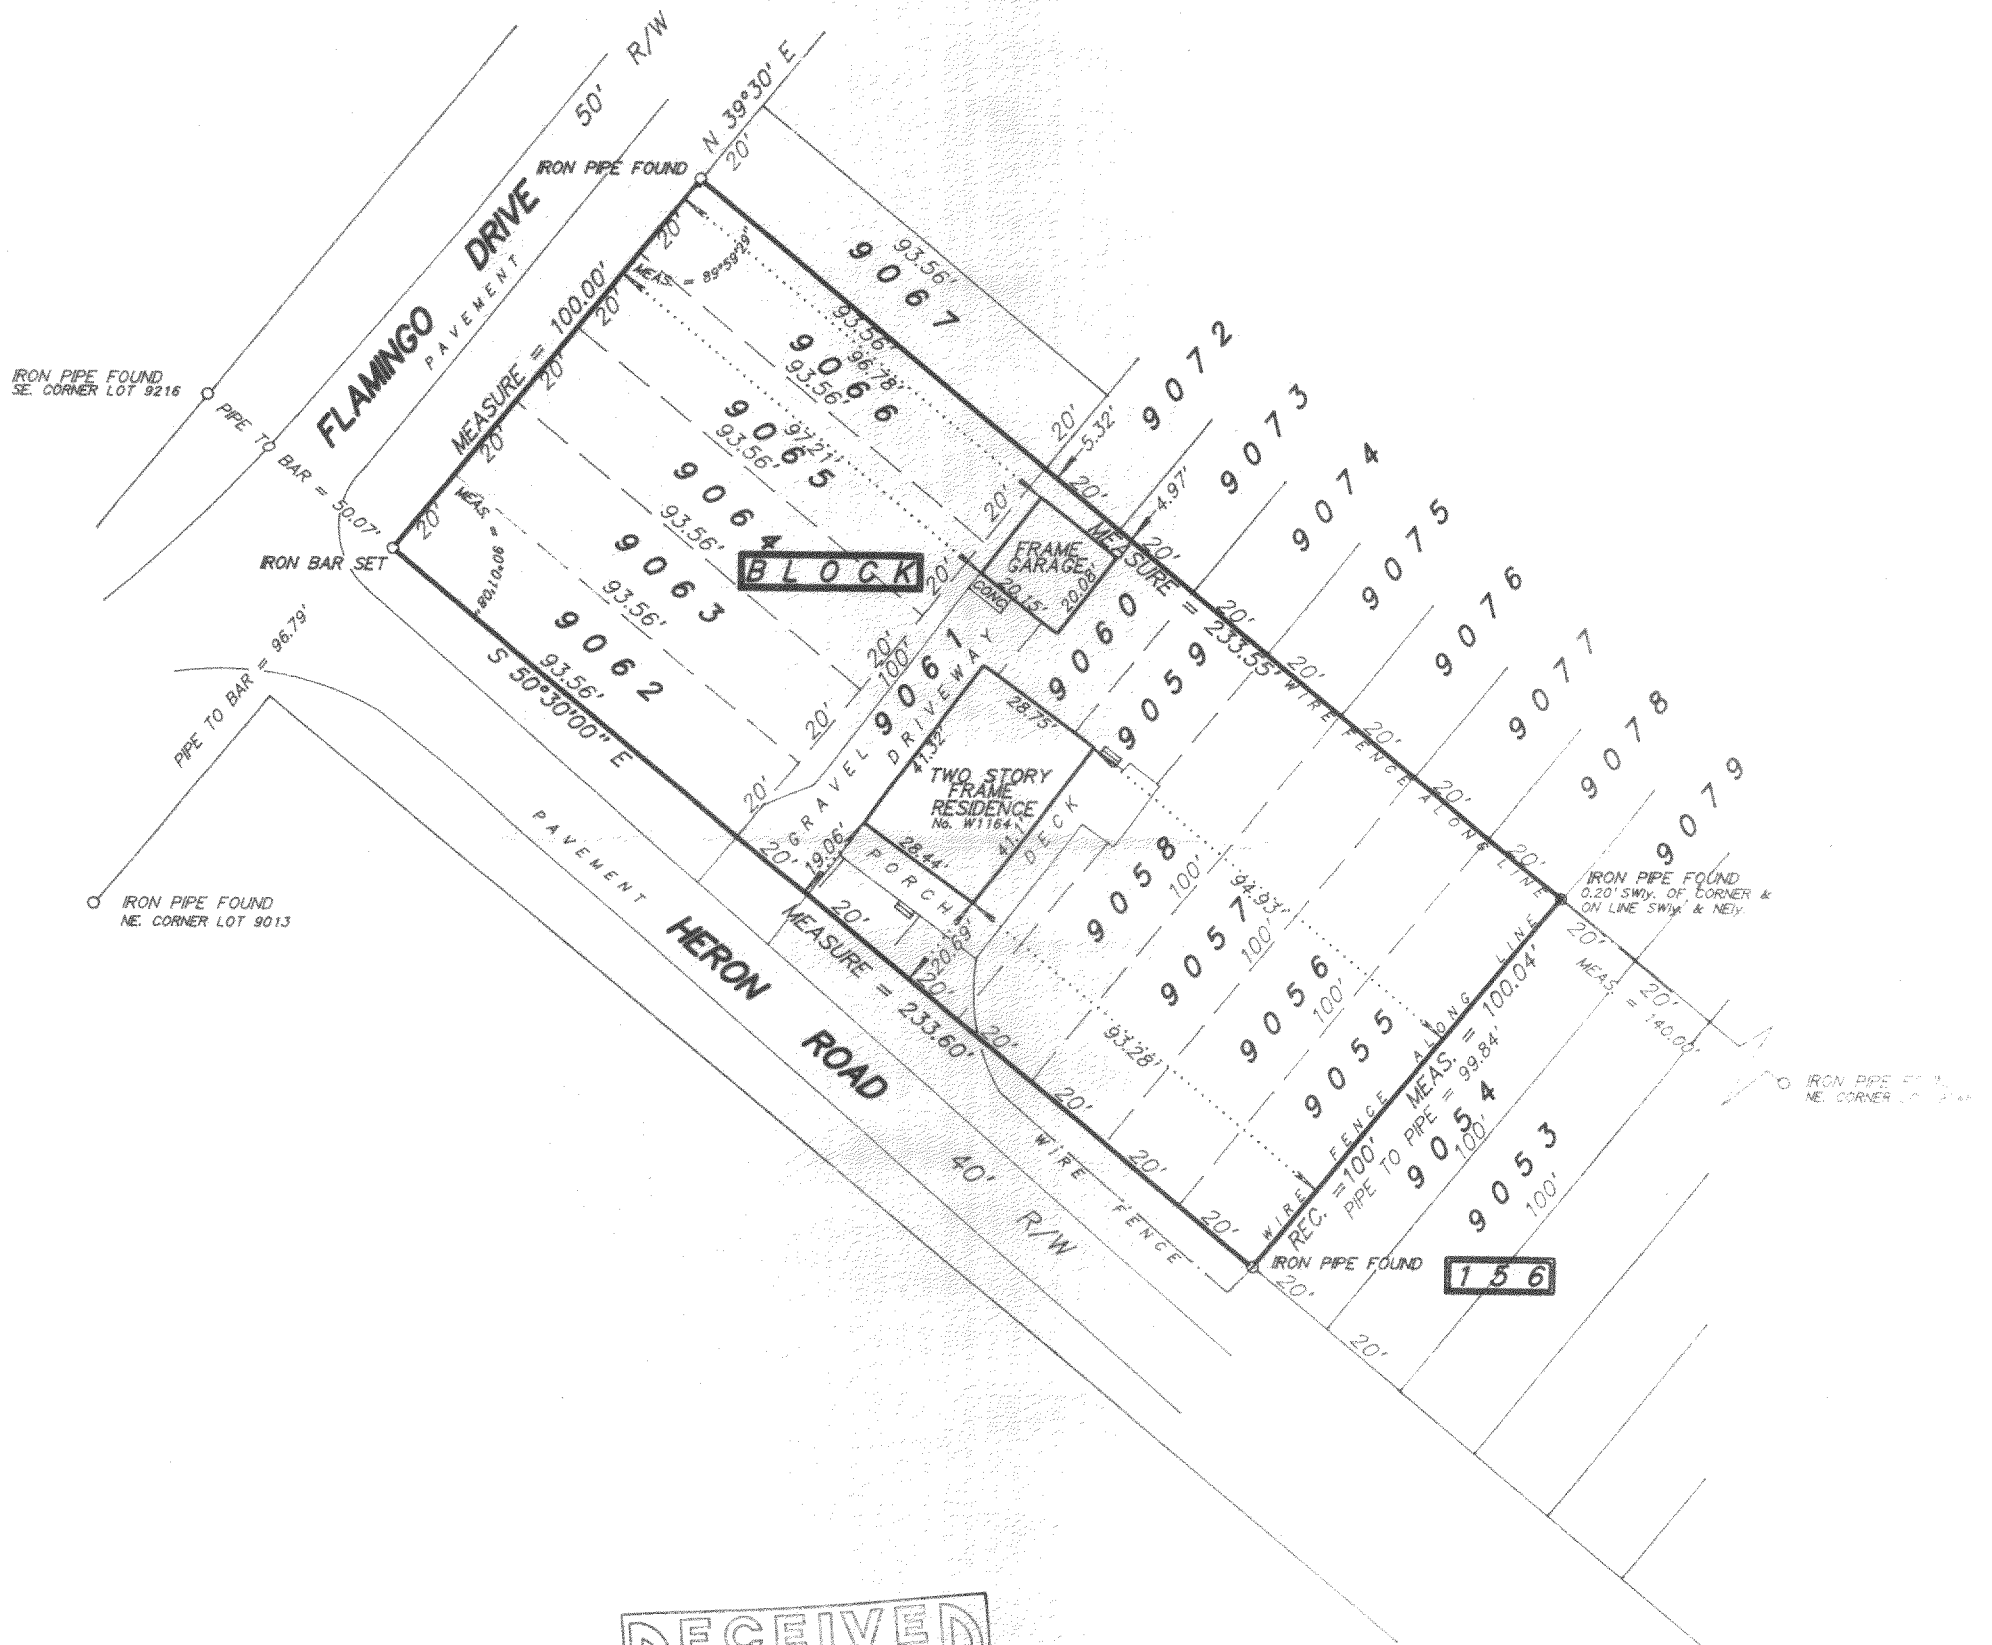

SCALE 1 inch = 40 feet

ORDERED BY M. Patryn

JOB NO. 02023

I hereby certify that I have surveyed the above described property and the above plat is a true representation thereof and shows the size and location of the property, its exterior boundaries, the location and dimensions of all visible structures thereon, boundary fences, apparent easements and roadways and visible encroachments, if any.

This survey is made for the exclusive use of the present owners of the property, and also those who purchase, mortgage, or guarantee the title thereto within one year from the date hereof.

Dated at Bassett, Wisconsin this _____ day of _____, 2002.

Mark A. Bolender
Wisconsin Registered Land Surveyor S - 1784