


**SURVEYING & SUBDIVIDING  
DELAN, WISCONSIN 53115**

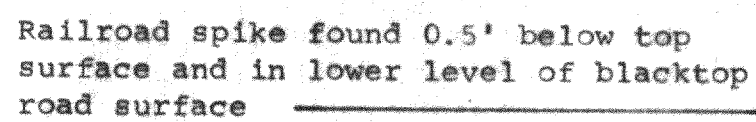

X = Iron Pipe Found  
 • = Railroad spike Found  
 X = 1/2" Iron Pipe set in blacktop  
 o = 3/4" Iron Pipe Set

Larry Morris  
9204 Creek Road  
Box 108  
Clinton, WI 53525

RECEIVED  
MAY 9 2003  
DRP

March 2, 2000

WISCONSIN  
 GEORGE T. DUNHAM  
 S. 306  
 DELAWARE  
 WIS.  
 LAND SURVEY