


PLAT OF SURVEY OF


Lots 1396 thru 1401, Block 31 of MAP OF SECTION 1 OF PELL LAKE, a subdivision located in Section 15, Township 1 North, Range 18 East of the 4th Principal Meridian, Township of Bloomfield, County of Walworth, State of Wisconsin.

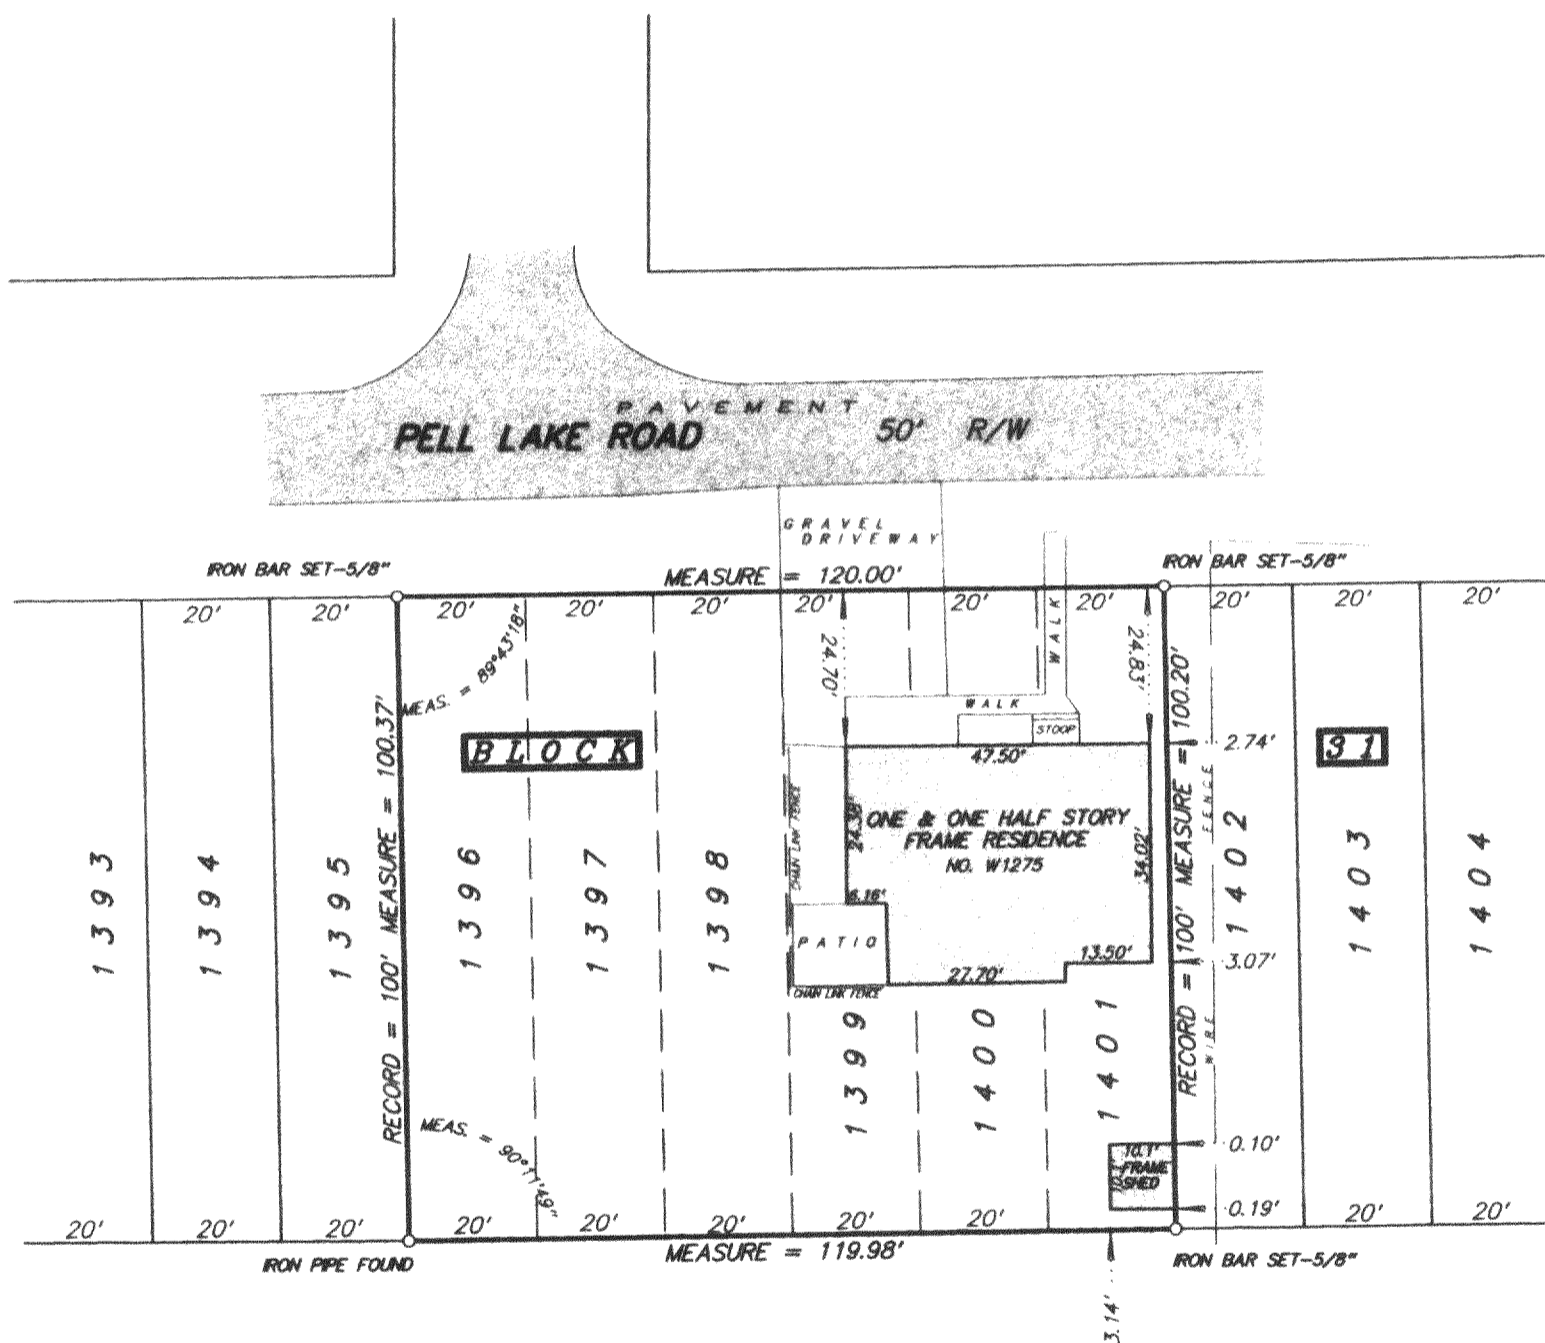

SCALE 1 inch = 30 feet

ORDERED BY J. Haase / Keefe Real Estate

JOB NO. 03193

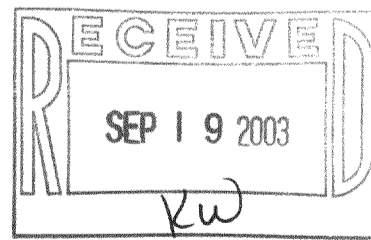

I hereby certify that I have surveyed the above described property and the above plat is a true representation thereof and shows the size and location of the property, its exterior boundaries, the location and dimensions of all visible structures thereon, boundary fences, apparent easements and roadways and visible encroachments, if any.

This survey is made for the exclusive use of the present owners of the property, and also those who purchase, mortgage, or guarantee the title thereto within one year from the date hereof.

Dated at Bassett, Wisconsin this _____ day of _____ 2003.

Mark A. Bolender
Wisconsin Registered Land Surveyor S - 1784

MPL-308

118-2317