
PREPARED FOR: COLDWELL BANKERS PRIMUS c\o DEBBIE COBAIN 226 BROAD STREET LAKE GENEVA WI 53147

PLAT OF SURVEY

J.K. SURVEYING INC. N3705 WILLOWBEND LANE LAKE GENEVA, WI, 53147 262-248-3697

- OF -

LOTS 1764-1773, BLOCK 40, PELL LAKE SUBDIVISION, PLAT MAP PAGE 4, TOWN 1 NORTH, RANGE 18 EAST, TOWN OF BLOOMFIELD, WALWORTH COUNTY, WISCONSIN

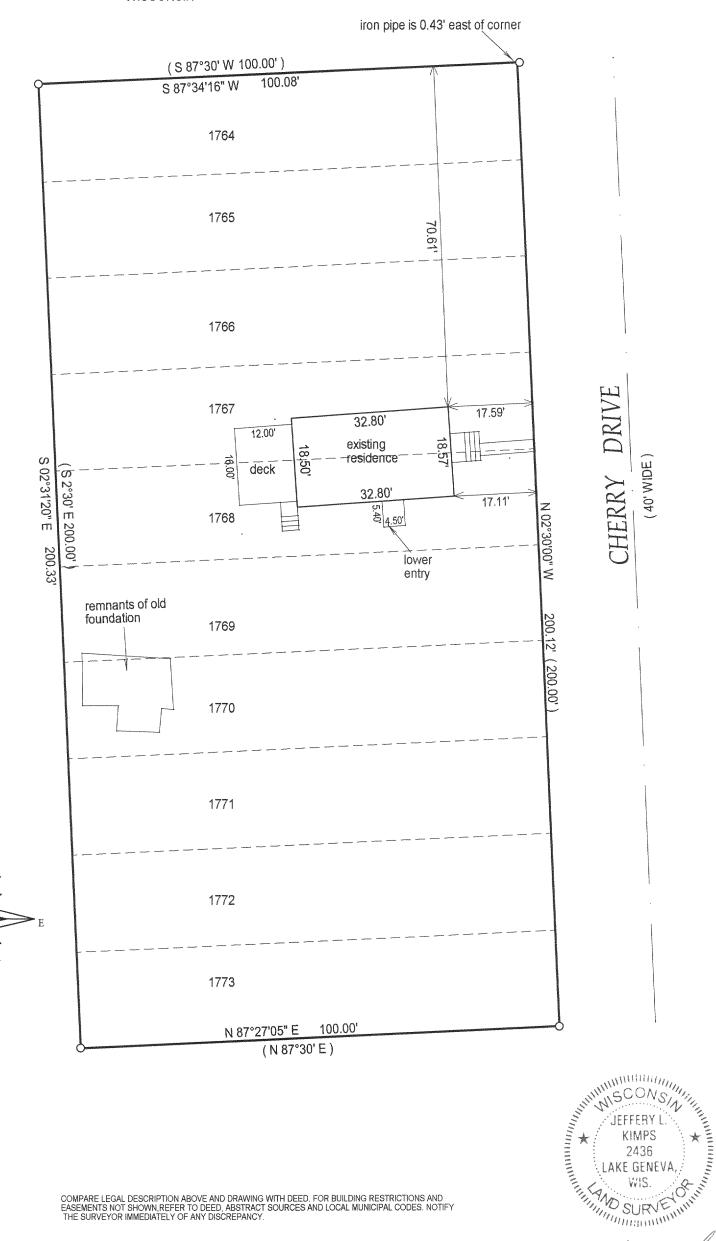

()= recorded as

S

O - 3 7 7 7

DRA

□ = found iron bar

= found iron pipe

= set iron pipe

= set iron bar

SCALE 1" = 20'

JOB # 03-557

TAXID # MPL 00383 COMPARE LEGAL DESCRIPTION ABOVE AND DRAWING WITH DEED. FOR BUILDING RESTRICTIONS AND EASEMENTS NOT SHOWN, REFER TO DEED, ABSTRACT SOURCES AND LOCAL MUNICIPAL CODES. NOTIFY THE SURVEYOR IMMEDIATELY OF ANY DISCREPANCY.

"I hereby certify that I have surveyed the above described property and that the above map is a true representation thereof and shows the size and location of all visible structures, apparent easements and encroachments

This survey is made for the present owners of the property, and those who purchase, mortgage, or guarantee the title thereto, within one year from the date hereof.

_TH, DAY OF <u>SEPT.</u>

DATED THIS

2003

JEFFREY L KIMPS S-2436 Wisconsin Registered Land Surveyor (original if signed in red)