



PREPARED FOR : RHYNERS CONS.

PLAT OF SURVEY

- OF -

LOTS 9222-9227 BLOCK 159 PELL LAKE SUBDIVISION,  
A SUBDIVISION LOCATED IN SECTION 22, TOWN 1 NORTH,  
RANGE 18 EAST, TOWN OF BLOOMFIELD, WALWORTH  
COUNTY, WISCONSIN

J.K. SURVEYING INC.  
N3705 WILLOWBEND LANE  
LAKE GENEVA, WI, 53147  
262-248-3697

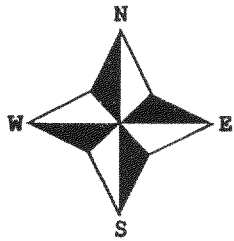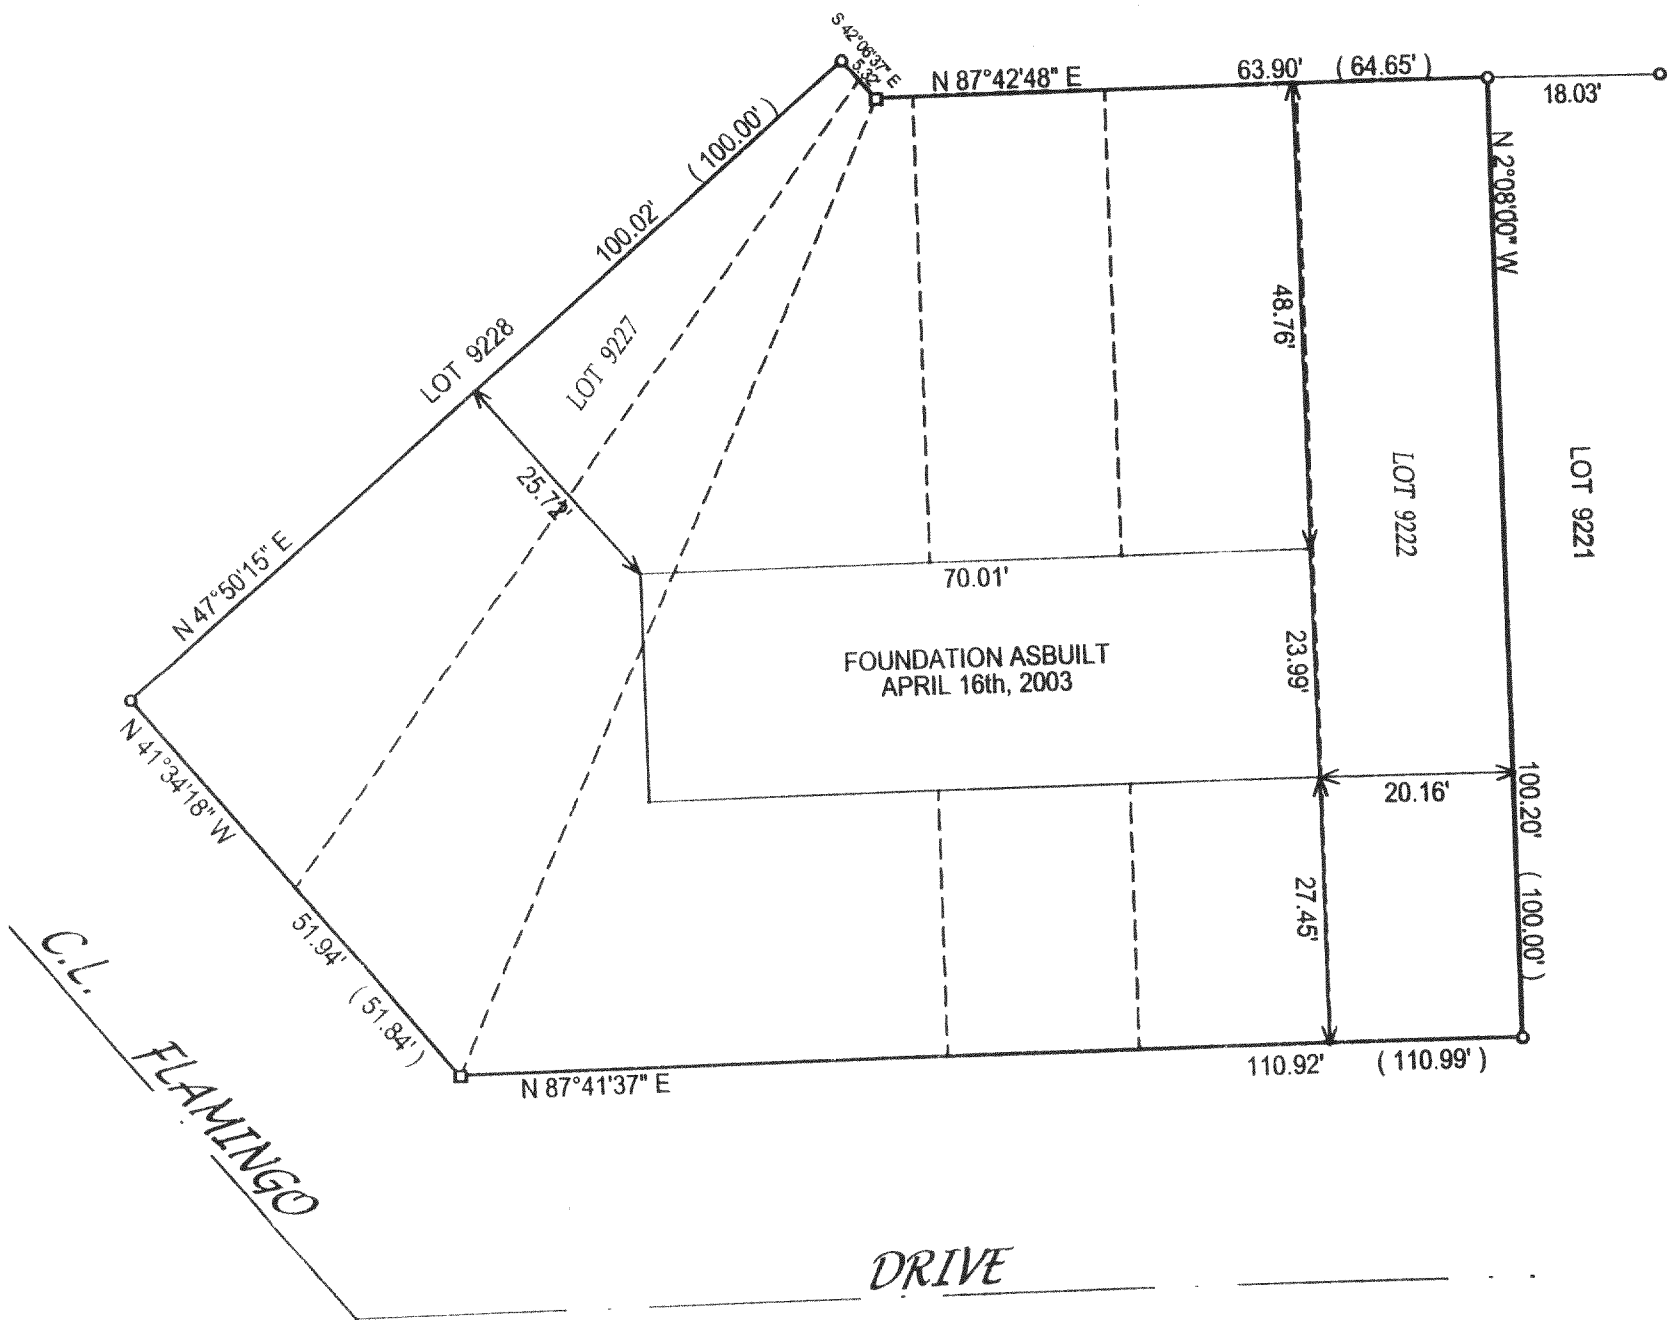


- ( ) = recorded as
- = found iron bar
- = found iron pipe
- = set iron pipe
- = set iron bar

SCALE 1" = 20'

JOB # 02-393

TAX ID # MPL 1867

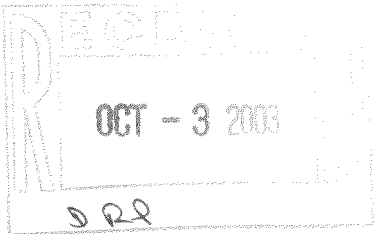

DATE OF LAST REVISION 04-16-03


NOTE : BASIS OF BEARING IS MAGNETIC NORTH.

COMPARE LEGAL DESCRIPTION ABOVE AND DRAWING WITH DEED. FOR BUILDING RESTRICTIONS AND EASEMENTS NOT SHOWN REFER TO DLED, ABSTRACT SOURCES AND LOCAL MUNICIPAL CODES. NOTIFY THE SURVEYOR IMMEDIATELY OF ANY DISCREPANCY.

"I hereby certify that I have surveyed the above described property and that the above map is a true representation thereof and shows the size and location of all visible structures, apparent easements and encroachments if any."

This survey is made for the present owners of the property, and those who purchase, mortgage, or guarantee the title thereto, within one year from the date hereof.

DATED THIS THE 5th DAY OF AUGUST 2002.

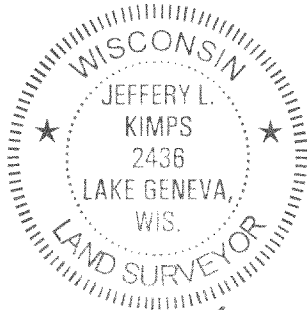

*Jeffery L. Kimps*  
JEFFERY L. KIMPS S - 2436  
Wisconsin Registered Land Surveyor  
( original if signed in red )

118-2331