
PREPARED FOR:
TERRI NIERGARTH
HIBL'S REAL ESTATE SALES INC.
1034-B ANN STREET
DELAVAN, WI. 53115

PLAT OF SURVEY

J.K. SURVEYING INC. N3705 WILLOWBEND LANE LAKE GENEVA, WI, 53147 262-248-3697

- OF -

LOTS 225 THRU 231, BLOCK 4 PELL LAKE HIGHLANDS, ACCORDING TO THE RECORD PLAT THEREOF, AS RECORDED IN THE OFFICE OF THE REGISTER OF DEEDS FOR WALWORTH COUNTY AND THE STATE OF WISCONSIN, ON THE 12TH DAY OF JUNE. 1925 IN VOLUME 8 OF PLATS PAGE 27.

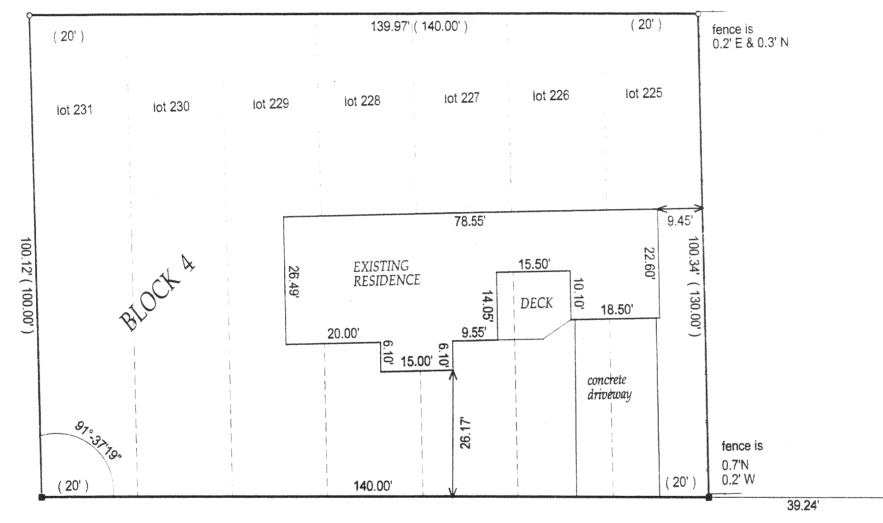

()= recorded as

= found iron bar

= found iron pipe

= set iron pipe

= set iron bar

SCALE 1" = 20"

JOB # 03-148

√ TAX ID # MPLH 00049

OCT - 3 2003

2000

FAIRVIEW ROAD

COMPARE LEGAL DESCRIPTION ABOVE AND DRAWING WITH DEED. FOR BUILDING RESTRICTIONS AND EASEMENTS NOT SHOWN, REFER TO DEED, ABSTRACT SOURCES AND LOCAL MUNICIPAL CODES. NOTIFY THE SURVEYOR MANEDIATELY OF ANY DISCREPANCY.

"I hereby certify that I have surveyed the above described property and that the above map is a true representation thereof and shows the size and location of all visible structures, apparent easements and encroachments if any."

This survey is made for the present owners of the property, and those who purchase, mortgage, or guarantee the title thereto, within one year from the date hereof. DATED THIS ___03 __TH, DAY OF __APRIL __20 __03



JEFFREY L KIMPS S-2436 Wisconsin Registered Land Surveyor (original if signed in red)