
ABELL SURVEYING & MAPPING

1140 SEQUOIA STREET . DELAVAN, WISCONSIN 53115 262-728-6737

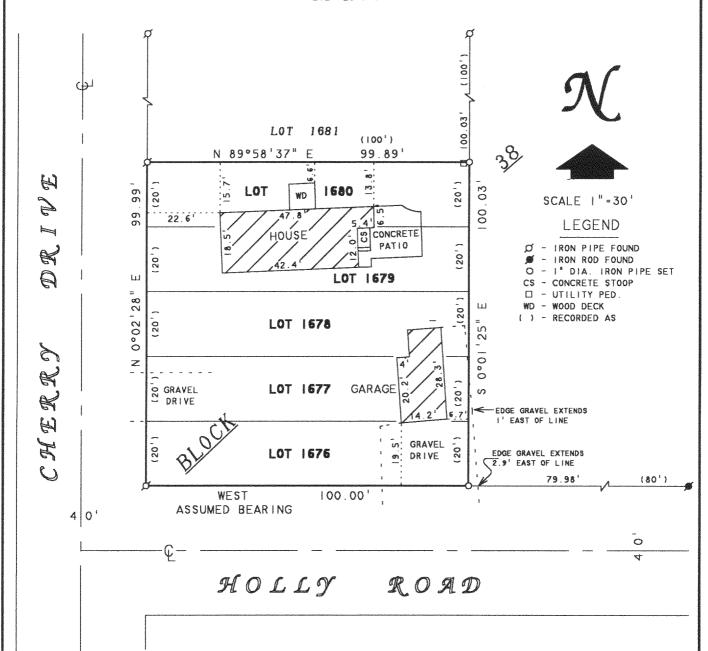

PLAT OF SURVEY OF

LOTS 1676-1680, BLOCK 38. PELL LAKE SUBDIVISION, TIN, RISE, WALWORTH COUNTY, WISCONSIN, CONTAINING 0.23 ACRES.

ORDERED BY:

DAN HURZELER NI206 COUNTY HIGHWAY "H" GENOA CITY, WI 53128

I HEREBY CERTIFY THAT I HAVE SURVEYED THE ABOVE DESCRIBED PROPERTY AND THAT THE ABOVE MAP IS A TRUE REPRESENTATION THEREOF AND SHOWS THE SIZE AND LOCATION OF THE PROPERTY, ITS EXTERIOR BOUNDARIES. THE LOCATION OF ALL VISIBLE STRUCTURES AND DIMENSIONS OF ALL PRINCIPAL BUILDINGS THEREON, BOUNDARY FENCES, APPARENT EASEMENTS, ROADWAYS AND VISIBLE ENCROACHMENTS, IF ANY, TO THE BEST OF MY KNOWLEDGE AND BELIEF.

THIS SURVEY IS MADE FOR THE USE OF THE PRESENT OWNERS OF THE PROPERTY, AND ALSO THOSE THOS

DAVID F. ABELL WISCONSIN REGISTERED LAND SURVEYOR, 3-1596

February 18, 2004

02011B JOB NUMBER THIS IS NOT A CERTIFIED COPY UNLESS SEALED.

