
## **ABELL** SURVEYING & MAPPING

1140 SEQUOIA STREET . DELAVAN, WISCONSIN 53115 262-728-6737

FLORENCE

0


ROAD

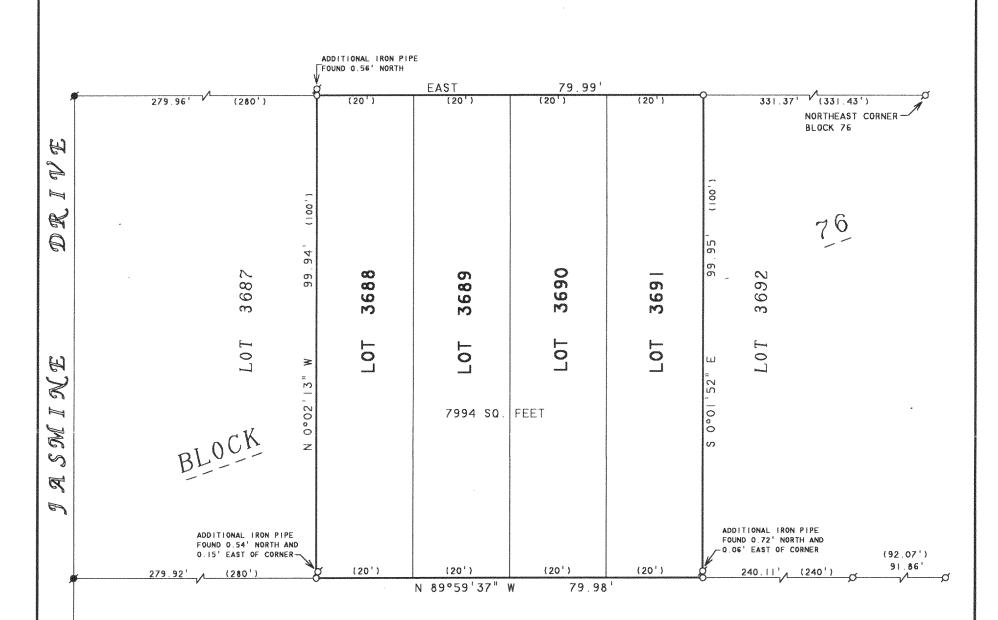

## PLAT OF SURVEY OF

LOTS 3688-3691, BLOCK 76, PELL LAKE SUBDIVISION, TIN, RIBE, WALWORTH COUNTY, WISCONSIN.

> ORDERED BY: CENTURY 21 - PAGLIARINI GROUP 252 CENTER STREET LAKE GENEVA. WI 53147

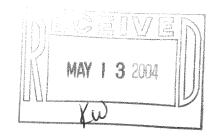

NOTE: BEARINGS ARE REFERENCED TO EXISTING SURVEY RECORDS.





SCALE | " = 20 '

LEGEND

Ø - IRON PIPE FOUND O - IRON PIPE SET

₩ - IRON ROD FOUND ( ) - RECORDED AS

I HEREBY CERTIFY THAT I HAVE SURVEYED THE ABOVE DESCRIBED PROPERTY AND THAT THE ABOVE MAP IS A TRUE REPRESENTATION THEREOF AND SHOWS THE SIZE AND LOCATION OF THE PROPERTY, ITS EXTERIOR BOUNDARIES, THE LOCATION OF ALL VISIBLE STRUCTURES AND DIMENSIONS OF ALL PRINCIPAL BUILDINGS THEREON, BOUNDARY FENCES, APPARENT EASEMENTS, ROADWAYS AND VISIBLE ENCROACHMENTS, IF ANY, TO THE BEST OF MY KNOWLEDGE AND BELIEF.

THIS SURVEY IS MADE FOR THE USE OF THE PRESENT OWNERS OF THE PROPERTY, AND ALSO THOSE WHO PURCHASE, MORTGAGE, OR GUARANTEE THE TITLE THERETO WITHIN ONE (I) YEAR FROM DATE HEREON.

WISCONSIN REGISTERED LAND SURVEYOR. S-1596

March 10, 2004

DATE NOTE: THIS IS NOT A CERTIFIED COPY UNLESS SEALED.

JOB NUMBER -

118-2430