
PREPARED FOR: HOMESTEAD REALTY C/O BOB LIMOSANI 520 BROAD STREET LAKE GENEVA, WI 53147


PLAT OF SURVEY

- OF -

LOTS 9412-9414 BLOCK 201 PELL LAKE SUBDIVISION LOCATED IN TOWN 1 NORTH, RANGE 18 EAST, WALWORTH COUNTY, WISCONSIN.

J.K. SURVEYING INC. N3705 WILLOWBEND LANE LAKE GENEVA, WI, 53147 262-248-3697

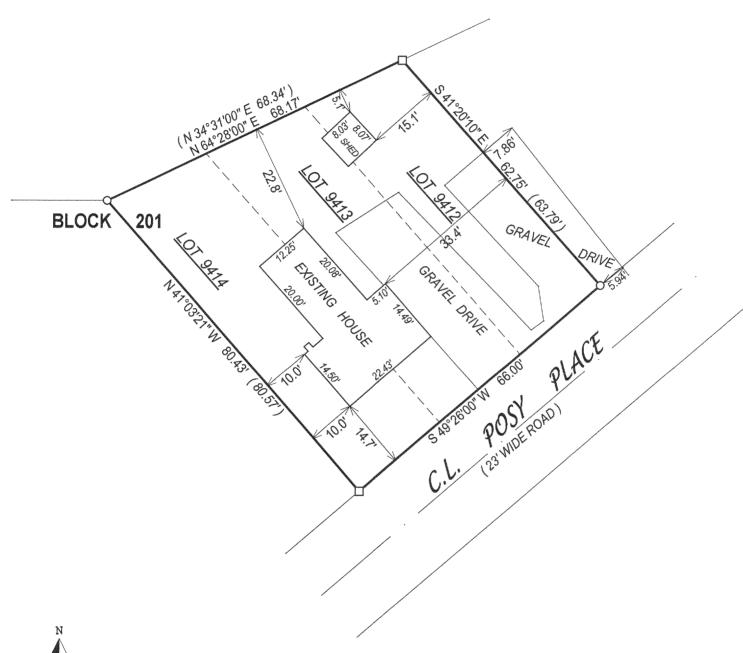

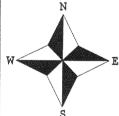

)= recorded as

= found iron bar


= found iron pipe

= set iron pipe

= set iron bar

SCALE 1" = 20"


JOB # 04-315

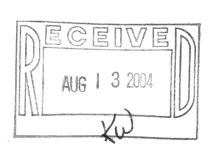

COMPARE LEGAL DESCRIPTION ABOVE AND DRAWING WITH DEED. FOR BUILDING RESTRICTIONS AND EASEMENTS NOT SHOWN, REFER TO DEED, ABSTRACT SOURCES AND LOCAL MUNICIPAL CODES. NOTIFY THE SURVEYOR IMMEDIATELY OF ANY DISCREPANCY.

"I hereby certify that I have surveyed the above described property and that __the above map, to the best of my knowledge and belief, is a true representation thereof and shows the size and location of all visible structures, apparent easements and encroachmentsif any.

This survey is made for the present owners of the property, and those who purchase, mortgage, or guarentee the title thereto, within one year from the date hereof

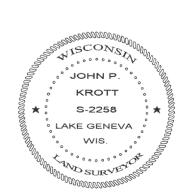

JOHN KROTT S - 2258
Wisconsin Registered Land Surveyor

(original if signed in red)

DATED THIS THE 9th DAY OF JUNE 2004

118-2454

TAX ID # MPL01909