PREPARED FOR: NEW CLASSIC HOMES, INC. 2319 S. HIDDEN TRAIL BLVD. SPRING GROVE, IL 60081


PLAT OF SURVEY


J.K. SURVEYING INC. N3705 WILLOWBEND LANE LAKE GENEVA, WI, 53147 262-248-3697

- OF -

LOTS 4229-4233 BLOCK 84 PELL LAKE SUBDIVISION, A SUBDIVISION LOCATED IN SECTION 15, TOWN 1 NORTH, RANGE 18 EAST, TOWN OF BLOOMFIELD, WALWORTH COUNTY, WISCONSIN

> HYACINTH ROAD C.L. (40' WIDE ROAD)

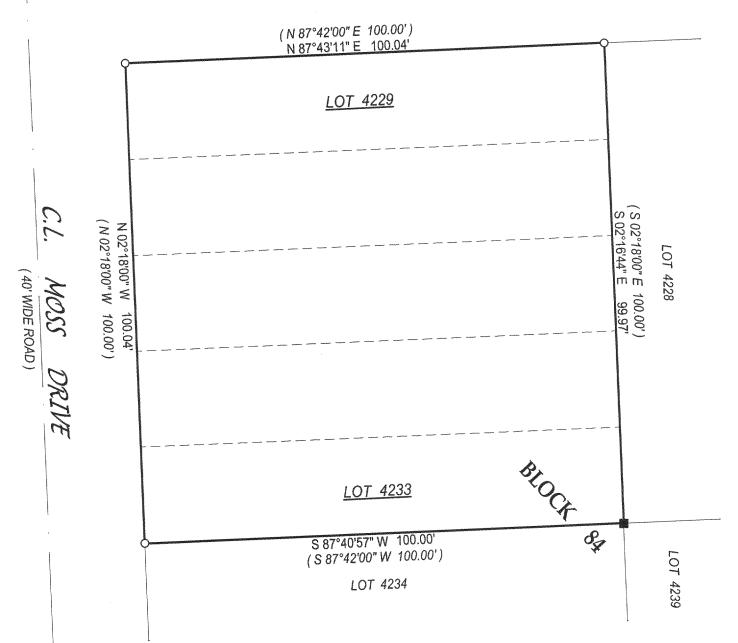

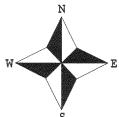

()= recorded as

= found iron bar

= found iron pipe


= set iron pipe

= set iron bar

SCALE 1" = 20'

JOB # 04-177

TAX ID # MPL00894

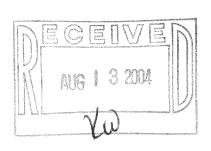

COMPARE LEGAL DESCRIPTION ABOVE AND DRAWING WITH DEED. FOR BUILDING RESTRICTIONS AND EASEMENTS NOT SHOWN, REFER TO DEED, ABSTRACT SOURCES AND LOCAL MUNICIPAL CODES. NOTIFY THE SURVEYOR IMMEDIATELY OF ANY DISCREPANCY.

"I hereby certify that I have surveyed the above described property and that the above map, to the best of my knowledge and belief, is a true representation thereof and shows the size and location of all visible structures, apparent easements and encroachmentsif any."

This survey is made for the present owners of the property, and those who purchase, mortgage, or guarentee the title thereto, within one year from the date hereof.



JOHN KROTT S - 2258

Wisconsin Registered Land Surveyor (original if signed in red)

DATED THIS THE 22nd DAY OF APRIL 2004.