


53-4

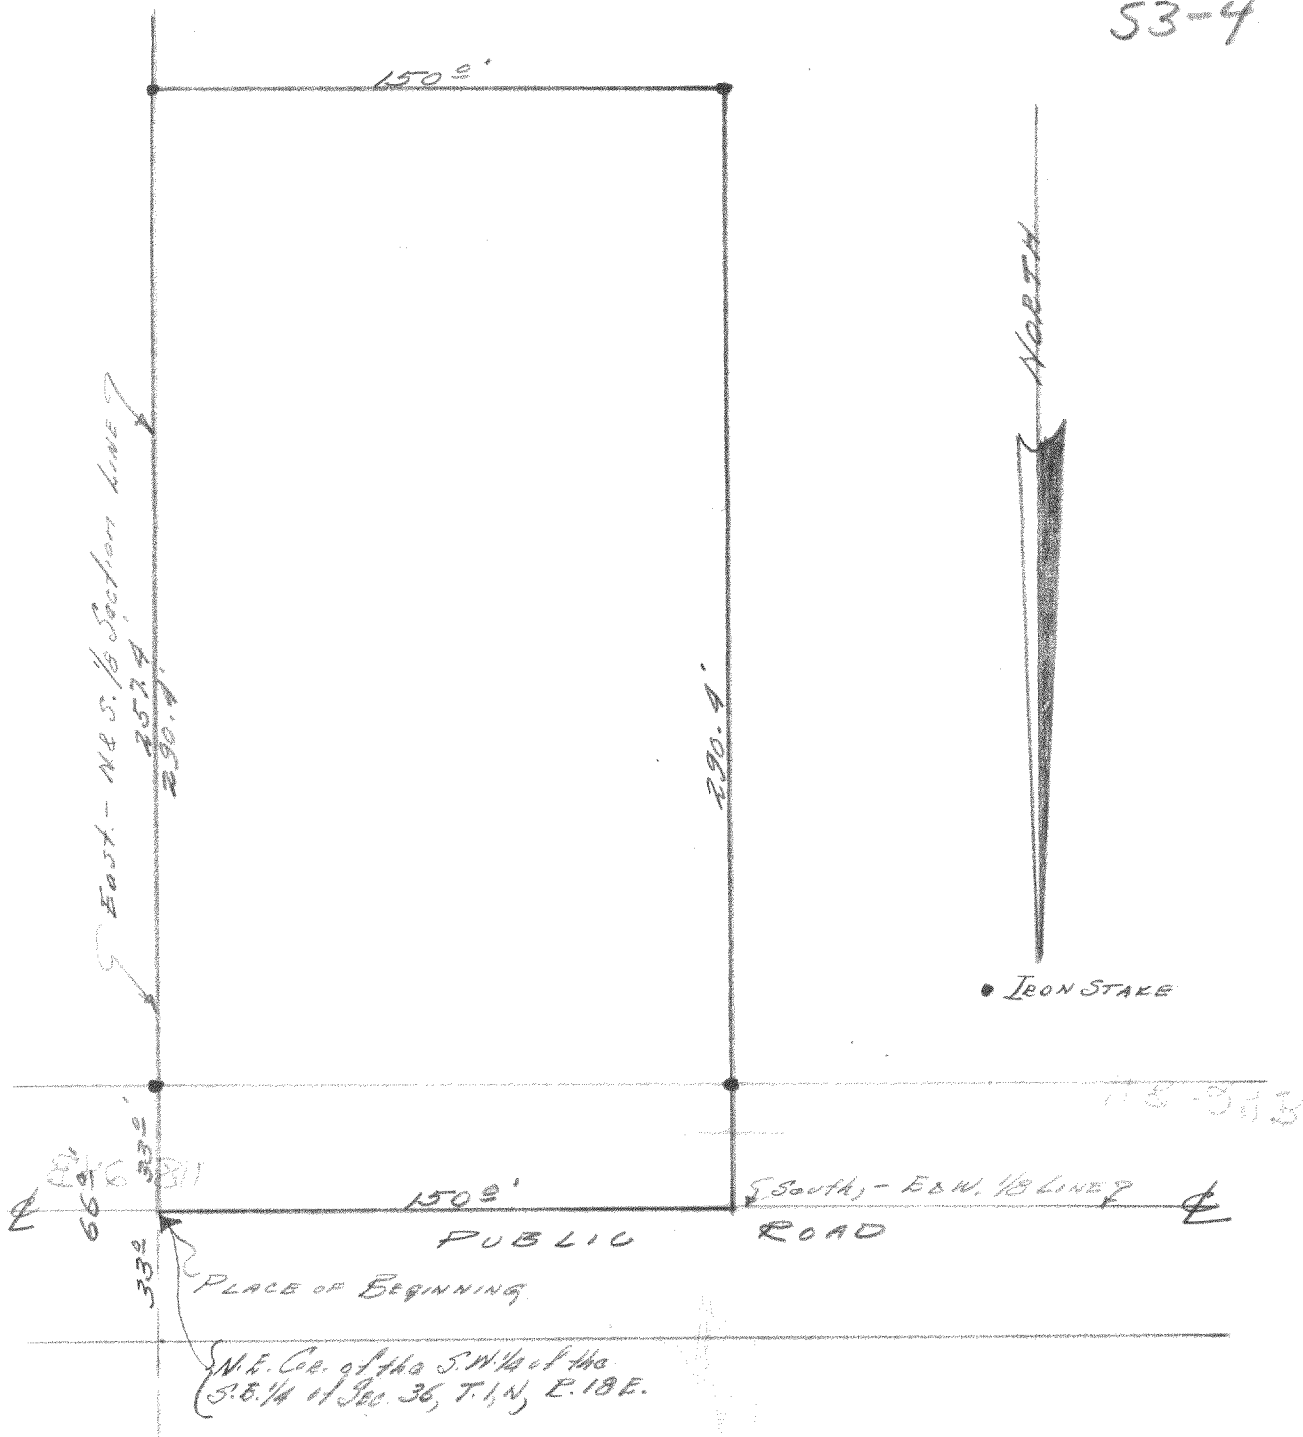

DESCRIPTION: Commencing at the N.E. corner of the S.W.  $\frac{1}{4}$  of the S.E.  $\frac{1}{4}$  of Section 36, Town 1 north, Range 18 east of the 4th Principal Meridian, thence West along the south; east and west 1/8 section line of said section 36, 150 feet to a point, thence South parallel with the east; north and south 1/8 section line of said section 36, 290.4 feet to an iron stake, thence East parallel with the aforesaid south; east and west 1/8 line, 150 feet to an iron stake on the aforesaid east; north and south 1/8 line, thence North along said 1/8 line 290.4 feet to the place of beginning. Containing one acre more or less.

CERTIFICATE: I, hereby certify that I have on this the 10th day of October 1953, surveyed the above described property and find that no encroachments exist.

SIGNED AND SEALED ON THIS THE 12TH DAY OF OCTOBER 1953.

Joseph M. Biagi, Professional Engineer.  
Elkhorn Wisconsin.

B-36-10A

118-24B