## PLAT OF SURVEY -0F-


LOTS 809-813, BLOCK 14 OF PELL LAKE ADDITION, LOCATED IN SECTIONS 14 AND 23, TOWNSHIP 1 NORTH, RANGE 18 EAST, TOWN OF BLOOMFIELD, WALWORTH COUNTY, WISCONSIN.

SURVEY FOR: YURI BUTINAS

SURVEY ADDRESS: W849 EAU CLAIRE ROAD

I HEREBY CERTIFY THAT THE EXISTING DWELLING UNDER CONSTRUCTION SHOWN ON THIS PLAT OF SURVEY IS LOCATED AS SHOWN THUS ( ), DATED THIS 12TH DAY OF NOVEMBER, 2004.


## (40' WIDE) EAU---CLAIRE---ROAD

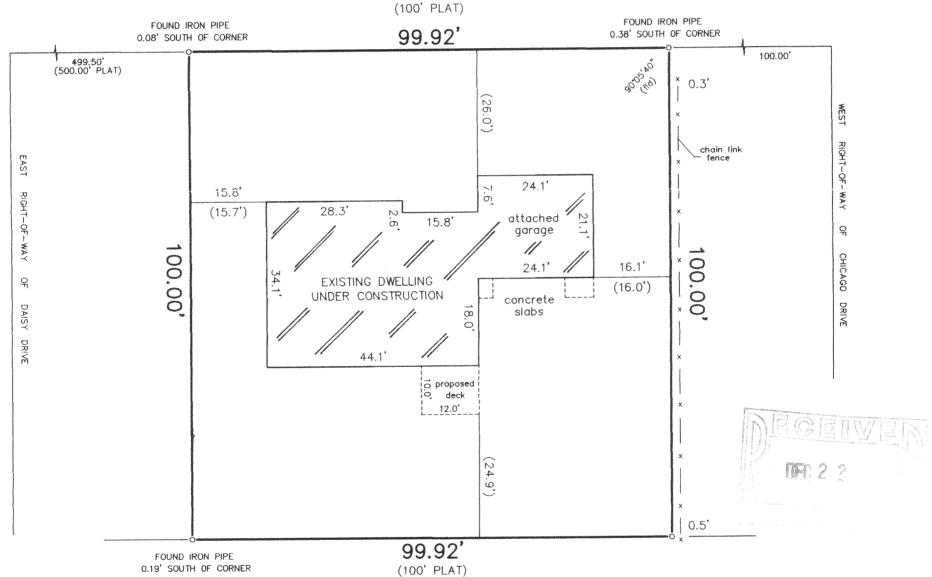

0.19' SOUTH OF CORNER

"I hereby certify that I have surveyed the above described property and that the above map is a correct representation thereof and shows the size and location of the property, its exterior boundaries, the location of all visible structures and dimensions of all principal buildings thereon, boundary fences, apparent easements, roadways and encroachments, if any."

"This survey is made for the use of the present owners of the property, and those who purchase, mortgage, or guarantee the title thereto within one year from date hereof."

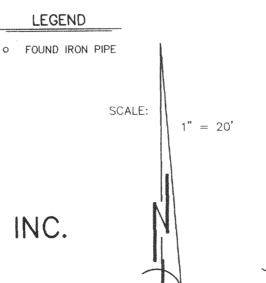



THIS IS NOT AN ORIGINAL PRINT UNLESS THIS SEAL IS RED.

B.W. SURVEYING, INC.

LAND SURVEYS MAPPING AND PLANNING 412 N. PINE STREET BURLINGTON, WI 53105 (262)-767-0225

S-2211 6379

JUNE 3, 2004 DATE

JOB NUMBER