
PLAT OF SURVEY


PHONE 262-537-4874

FAX 262-537-4221

OF

Lots 2251, 2252, 2253 and 2254, Block 51 of SECTION 2 PELL LAKE SUBDIVISION, being part of Section 22, Township 1 North, Range 18 East of the 4th Principal Meridian, Bloamfield Township, Walworth County, Wisconsin.

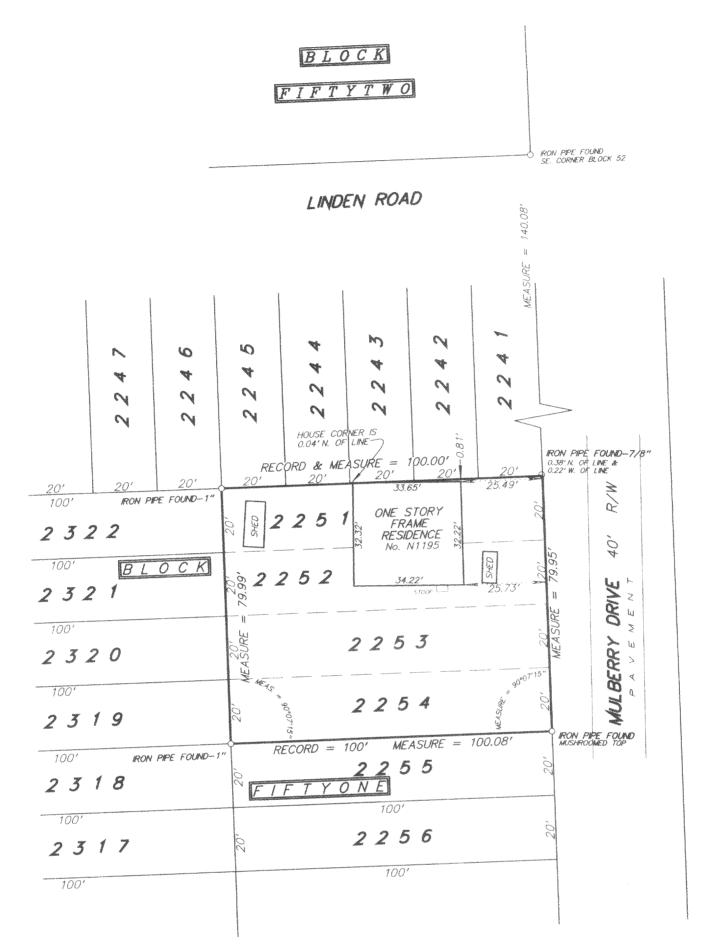


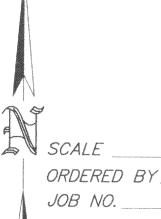

 SCALE
 1 inch = 30 feet

 ORDERED BY
 C. Minogue

 JOB NO.
 0 4 4 1 6

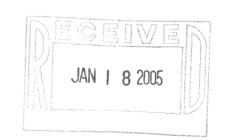

I hereby certify that I have surveyed the above described property and the above plat is a true representation thereof and shows the size and location of the property, its exterior boundaries, the location and dimensions of all visible structures thereon, boundary fences, apparent easements and roadways and visible encroachments, if any.

This survey is made for the exclusive use of the present owners of the property, and also those who purchase, mortgage, or guarantee the title thereto within one year from the date hereof.

Dated at Bassett, Wisconsin this _____ day of _____ 2004.

Mark A. Bolender Wisconsin Registered Land Surveyor S — 1784