



048315  
048315S1.DWG

LOTS 9681, 9682, 9683, 9684, 9685, AND 9686, BLOCK 215 OF SECTION 7 OF PELL LAKE SUBDIVISION, EXCEPTING THEREFROM THE FOLLOWING DESCRIBED PARCEL: BEGIN AT THE SOUTHERLY MOST CORNER OF LOT 9681; THENCE 58.66 FEET NORTHERLY ALONG THE EAST LINE OF LOT 9681; THENCE WESTERLY 69.15 FEET AT RIGHT ANGLES TO THE EAST LINE OF LOT 9681 TO THE WESTERLY LINE OF LOT 9683; THENCE SOUTHEASTERLY 90.68 FEET ALONG THE SOUTHWESTERLY LINE OF LOTS 9683, 9682 AND 9681 TO THE POINT OF BEGINNING. SAID LAND IS LOCATED IN THE NORTHEAST 1/4 OF SECTION 21, TOWN 1 NORTH, RANGE 18 EAST OF THE FOURTH PRINCIPAL MERIDIAN, TOWN OF BLOOMFIELD, COUNTY OF WALWORTH, STATE OF WISCONSIN.

EXCAVATOR TO EXPOSE SEWER LATERAL  
TO INSURE GRAVITY FLOW FROM BASEMENT

● - FOUND IRON PIPE  
○ - SET IRON PIPE  
( ) - RECORDED AS  
E = ELEVATIONS BASED ON  
SANITARY SEWER DATUM

SCALE: 1" = 30'

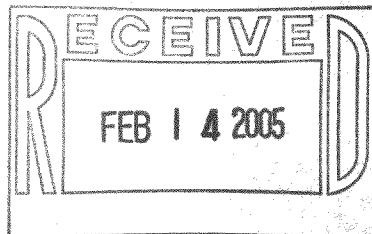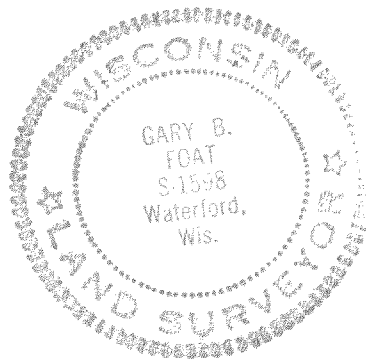

I HEREBY CERTIFY THAT I HAVE SURVEYED THE ABOVE DESCRIBED PROPERTY AND THE ABOVE MAP IS A TRUE REPRESENTATION THEREOF AND SHOWS THE SIZE AND LOCATION OF THE PROPERTY, THE LOCATION OF ALL VISIBLE STRUCTURES AND DIMENSIONS OF ALL PRINCIPAL BUILDINGS THEREON, BOUNDARY FENCES, APPARENT EASEMENTS, ROADWAY AND VISIBLE ENCROACHMENTS, IF ANY.

THIS SURVEY IS MADE FOR THE PRESENT OWNERS OF THE PROPERTY, AND ALSO THOSE WHO PURCHASE, OR GUARANTEE THE TITLE THERE TO WITHIN (1) YEAR FROM THE DATE HEREOF.

DATE AT WATERFORD THIS 14th DAY OF SEPTEMBER 20 04 REVISED: SEPT. 29, 2004  
 DATED HOUSE LOCATION

RECERTIFIED

MPL-1963

118-2562